

KANSAS


Butler

FORM 51 5M 6-46 PETROL

Section 7 Township 25 Range 5-E

Well No. #4 Pierpont (*Pierpoint*)

Company Wilson & Wixson

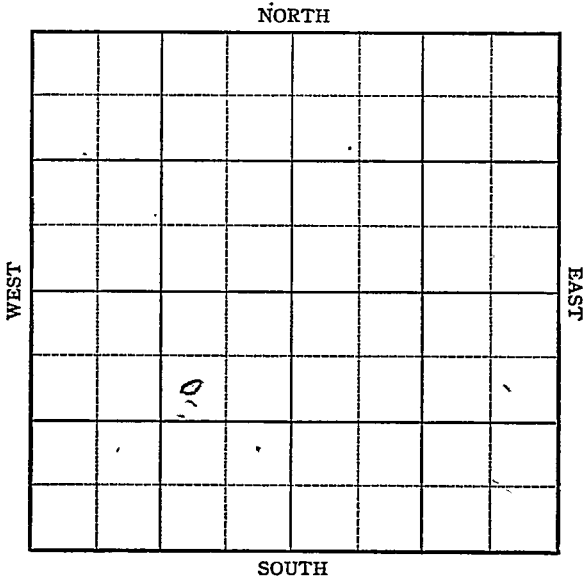

Sec. 7 Twp. 25 R. 5E

#4 Pierpont

Well No. _____ Farm _____

Wilson & Wixson

Company _____

Miscellaneous


990 _____ Ft. from N. Line

_____ Ft. from S. Line

990 _____ Ft. from E. Line

_____ Ft. from W. Line

SW NE SW

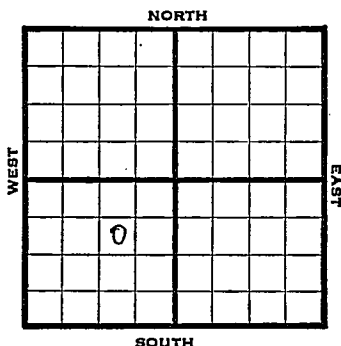

1946 1433 REPORT

- 8/14 Location
- 8/20 Mach
- 8/27 15" @ 208
Drlg 500'
- 9/5 12" @ 930
1640 Run 10'
- 9/10 Lans 1865
KC 2130'
8" @ 2195'
Drlg 2365'
- 9/18 Miss 2618
6" @ 2820'
TD 2827 HFO
- 9/25 Miss 2618'
6" @ 2820'
TD 2827'
Pump 25 POT
Grav 38

COMPLETED

Kansas Pool Name Miscellaneous

Map No. KANSAS Sec. 7 Twp. 25 R. 5E

Well No. 4 Pierpont

Wilson & Wixson Company

FIRST REPORT

Contractor

SW NE SW

SECTION PLAT

990 Ft. from N. Line

 Ft. from S. Line

990 Ft. from E. Line

 Ft. from W. Line

Butler County

RECORD

Location X

Cased in., ft.

Rig up

Sand

Drilling and Remarks:

Gas

Oil

Total Depth

PRODUCTION

1st 24 hrs. Nat.

1st 24 hrs. after shot

Gas Cu. Ft.

Dry Hole

Abandoned

Date

AUG 14 1946

19

S. J. LEWIS

Scout

KANSAS

Kansas Pool Name Miscellaneous

Map No. 14 Sec. 7 Twp. 25 R. 5E

Well No. 4 Pierpont

Wilson & Wixson Company

COMPLETED

Contractor

SW NE SW

E. J. H. S.

SECTION PLAT

990 Ft. from N. Line

_____ Ft. from S. Line

990 Ft. from E. Line

_____ Ft. from W. Line

Butler County

Location _____

Rig up _____

Drilling and Remarks:

Miss 2618

6" @ 2520

Pump 25 P. X

0820

RECORD

Cased _____ in., _____ ft.

Sand _____

Gas _____

Oil _____

Total Depth 2827

PRODUCTION

1st 24 hrs. Nat. _____

1st 24 hrs. after shot _____

Gas _____ Cu. Ft.

Dry Hole _____

Abandoned _____

Date

SEP 25 1946 19

S. J. LEWIS Scout