


Map No. N. 15 Sec. 2 Twp. 25 R. 8
 Well No. 1 blank (CLARK) Farm
Harwood Etal Company

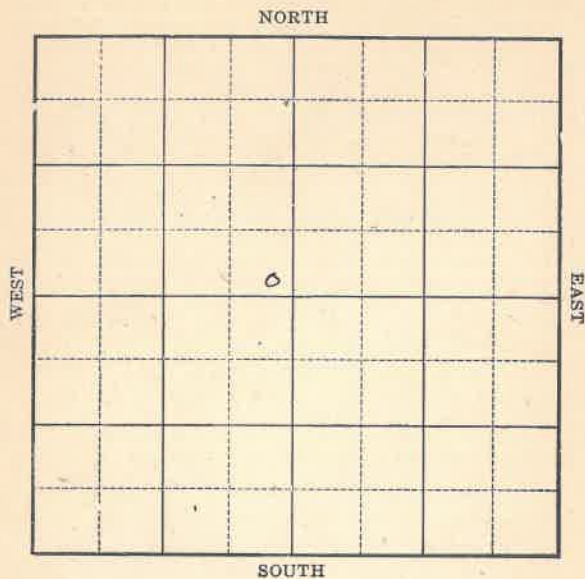

Location _____
 Drilling Remarks:

Rig Up _____
 Drilling Remarks:


RECORD

Cased _____ in. _____ ft.
 Sand _____
 Gas _____
 Oil _____
 Total Depth _____

PRODUCTION

1st 24 hrs. Nat. _____
 1st 24 hrs. after shot _____
 Gas _____ cu. ft.
 Dry Hole _____
 Abandoned _____

Map No. ST Sec. 2 Twp. 25 R. 8
 Well No. 1 blank (Clark) Farm
Harwood Etal Company

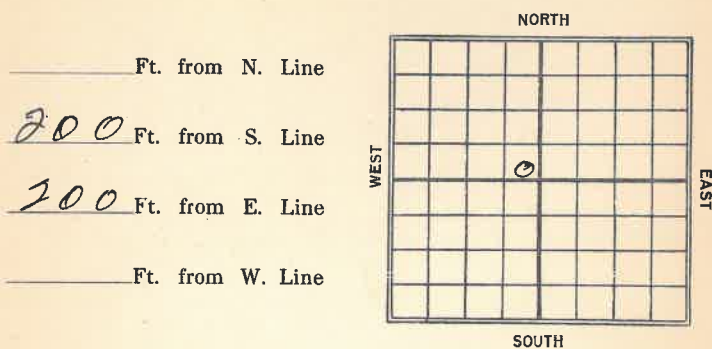

_____ Ft. from N. Line
200 Ft. from S. Line
200 Ft. from E. Line
 _____ Ft. from W. Line

Date

REPORT

1923
11/3 Rog.
7/16 sand. 2390 - 2398
LC + A. 2461'

Map No. KANSAS Sec. 2 Twp. 25 R. 8Well No. 1-Clark
Narwood et al Company
Contractor

FIRST REPORT

SECTION PLAT

_____ Ft. from N. Line
300 Ft. from S. Line
200 Ft. from E. Line
 _____ Ft. from W. Line

Location _____

Rig up _____

Drilling and Remarks:

R.O. G.

RECORD

Cased _____ in., _____ ft.

Sand _____

Gas _____

Oil _____

Total Depth _____

PRODUCTION

1st 24 hrs. Nat. _____

1st 24 hrs. after shot _____

Gas _____ Cu. Ft.

Dry Hole _____

Abandoned _____

Date

NOV 3 1923M. A. BENEAR

Scout

Map No. 15 Kansas Sec. 2 Twp. 25 R. 8Well No. 1-Clark
Narwood et al Company
Contractor

ABANDONED

SECTION PLAT

_____ Ft. from N. Line
200' Ft. from S. Line
200' Ft. from E. Line
 _____ Ft. from W. Line

Location _____

Rig up _____

Drilling and Remarks:

S. 2390-2398
W 49 2461'

RECORD

Cased _____ in., _____ ft.

Sand _____

Gas _____

Oil _____

Total Depth _____

PRODUCTION

1st 24 hrs. Nat. _____

1st 24 hrs. after shot _____

Gas _____ Cu. Ft.

Dry Hole _____

Abandoned _____

Date

M.A.B. 7/23/24

Scout