

Map No. Kansas Sec. 8 Twp. 25 R. 5


Well No. 155 Wilson Farm
Empire Company

_____ Ft. from N. Line

330 Ft. from S. Line

990 Ft. from E. Line

_____ Ft. from W. Line

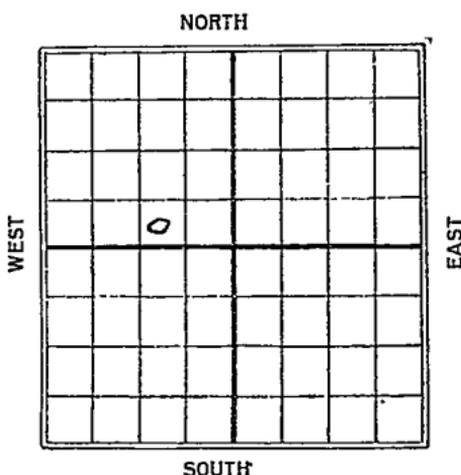

To be a deep well

Date
1925

REPORT

3/1 Rgn up

5/21 2416-2452 T.D. 2456

521 Bbls 1st 24 hrs

Map No. 14 ~~ARCAS~~ Sec. 8 Twp. 25 R. 5

Well No. 155 Wilson

Empire Company

Contractor

To be a deep well SECTION PLAT

FIRST REPORT
Ft. from N. Line

330 Ft. from S. Line

990 Ft. from E. Line

_____ Ft. from W. Line

	0		

Location _____

Rig up _____

Drilling and Remarks:

Rign up.

RECORD

Cased _____ in., _____ ft.

Sand _____

Gas _____

Oil _____

Total Depth _____

PRODUCTION

1st 24 hrs. Nat. _____

1st 24 hrs. after shot _____

Gas _____ Cu. Ft.

Dry Hole _____

Abandoned _____

Date

3/1 1924

M. A. BENEAR Scout

Map No. 11626 Sec. 8 Twp. 25 R. 5

Well No. 155 Wilson

Empire Oil & Fuel Co. Company

Contractor

COMPLETED

SECTION PLAT

_____ Ft. from N. Line

330 Ft. from S. Line

990 Ft. from E. Line

_____ Ft. from W. Line

Location _____

Rig up _____

Drilling and Remarks:

Pay 2429-36'

Rumped 521 bls
1st 24 hours.

RECORD

Cased _____ in., _____ ft.

Sand 2416-2452'

Gas _____

Oil _____

Total Depth 2456

PRODUCTION

1st 24 hrs. Nat. 521 bls

1st 24 hrs. after shot _____

Gas _____ Cu. Ft.

Dry Hole _____

Abandoned _____

Date

MAY 21 1925

CHAS. L. SHERWOOD

Scout