


Map No. Kane Sec. 8 Twp. 25 R. 5
 Well No. 155 Wilson Farm
Empire G & F Company

_____ Ft. from N. Line

300 Ft. from S. Line

1020 Ft. from E. Line

_____ Ft. from W. Line

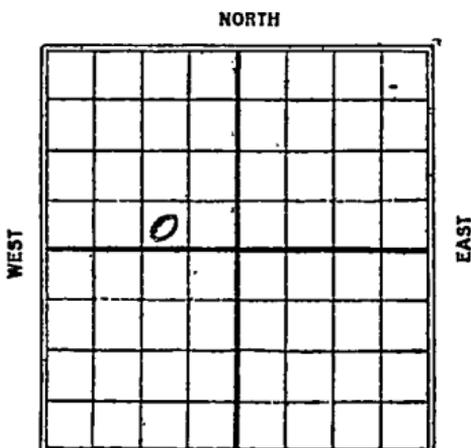

1925 O.W.O.A.O.

Date REPORT

8/7 Running 8/4-2495'

8/14 U.R. - T.D. 2626'

8/20

8/27 2700'

9/13 2800'

9/11 Log. U.R. Log 5. 2825'

9/16 Log 2903

9/24 ✓ 2980'

10/1 ✓ 3050

10/8 BT 3071 Top. granite 3050

10/16 Sand 2415-2456 T.D. 3050

(Pumping 80 Bbls)

Map No. 25 Sec. 8 Twp. 25 R. 5

Well No. 155 Wilson
Empire Oil & Fuel Co. Company

Contractor

FIRST REPORTS

SECTION PLAT

_____ Ft. from N. Line

300 Ft. from S. Line

1020 Ft. from E. Line

"old producing well"
 _____ Ft. from W. Line

going to make deep test

			Λ
	o		

Location _____

Rig up _____

Drilling and Remarks:

Burning 8 1/4" @
2495'

RECORD

Cased _____ in., _____ ft.

Sand _____

Gas _____

Oil _____

Total Depth _____

PRODUCTION

1st 24 hrs. Nat. _____

1st 24 hrs. after shot _____

Gas _____ Cu. Ft.

Dry Hole _____

Abandoned _____

Date

AUG 7 1925

CHAS. L. SHERWOOD

Scout

Butler Co

Map No. K14 KANSAS Sec. 8 Twp. 25 R. 5

Well No. 155 Weldon

Empire Oil & Gas Co Company

Contractor

COMPLETED

SECTION PLAT

	0		

Ft. from N. Line

300

Ft. from S. Line

1070

Ft. from E. Line

Ft. from W. Line

old well deeper.

RECORD

Location -----

Rig up -----

Drilling and Remarks:

Top of sand 3050'

Plugged back to

level 2415-56'

Pumping 80 bhs.

Cased _____ in., _____ ft.

Sand 2415-2456

Gas -----

Oil -----

Total Depth 3050'

PRODUCTION

1st 24 hrs. Nat. -----

1st 24 hrs. after shot -----

Gas ----- Cu. Ft.

Dry Hole -----

Abandoned -----

Date ✓

OCT 16 1925

CHAS. L. SHERWOOD

192 _____ Scout