KANSAS

FORM 51 5M 4-41 PETROL


Butler

Section 8 Township 25 Range 5-E

Well No. 197 Wilson

Company Cities Service Oil

Eldorado Pool

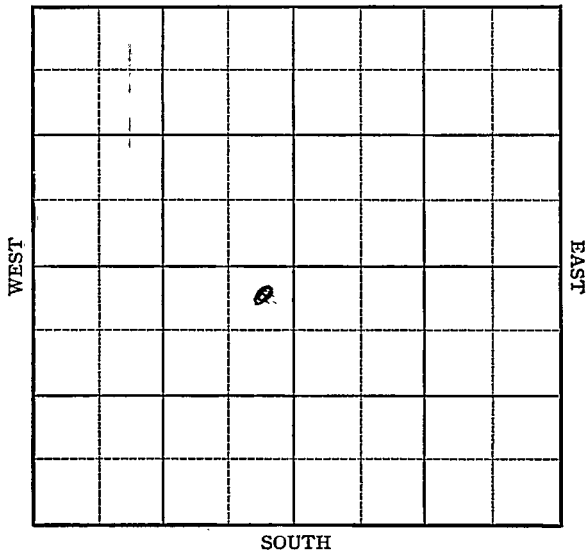

FORM 252-A 5M 1-41 PETROL KANSAS Butler

Sec. 8 Twp. 25 R. 5-E

Well No. #197 Wilson Farm

Cities Service Oil Company


(Eldorado)

330 Ft. from N. Line

_____ Ft. from S. Line

355 Ft. from E. Line

_____ Ft. from W. Line

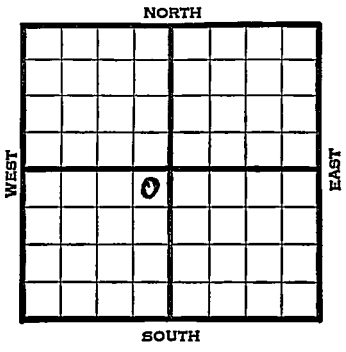

1941	REPORT
5/7	S. H.
5/15	K.C. 1958' 7" - 1965'
	T.D. 2073' RUST.
5/22	" " "
5/28	" " "
6/5	" " "
6/11	K.C. 1958'
	7" - 1965'
	T.D. 2011'
	2000 acid.
	Potential 98 bbls., pump.
	36. Gravity
	COMPLETED

Form 26—200 Bks.—1-40—Palace Butler KANSAS

Map No. 14 Sec. 8 Twp. 25 R. 5E

Well No. 197 Wilson

Cities Service Oil Company

Contractor

FIRST REPORT

NE SW

330 Ft. from N. Line


_____ Ft. from S. Line

355 Ft. from E. Line

_____ Ft. from W. Line

ELDORADO POOL

SECTION PLAT

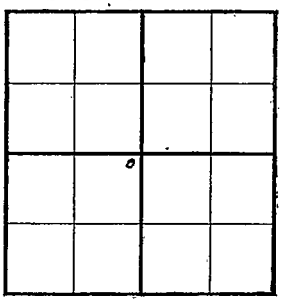

Location _____

Rig up _____

Drilling and Remarks:

S.H.

RECORD

Cased _____ in., _____ ft.

Sand _____

Gas _____

Oil _____

Total Depth _____

PRODUCTION

1st 24 hrs. Nat. _____

1st 24 hrs. after shot _____

Gas _____ Cu. Ft.

Dry Hole _____

Abandoned _____

Date

MAY 7 1941 19

S. J. LEWIS Scout

Form 26—200 Bks.—1-40—Palace Butler KANSAS

Map No. 14 Sec. 8 Twp. 25 R. 5E

Well No. 197 Wilson

Cities Service Oil Company

Contractor

COMPLETED

NE SW

330 Ft. from N. Line


Ft. from S. Line

355 Ft. from E. Line

Ft. from W. Line

ELDORADO POOL

SECTION PLAT

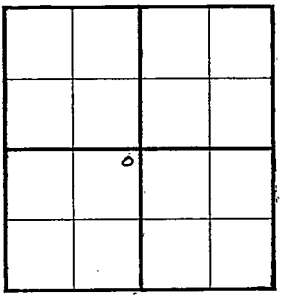

Location

Rig up

Drilling and Remarks:

KC 1958

7" @ 1963

2000 acid

Pump 98 BO

36° Gr

RECORD

Cased in., ft.

Sand

Gas

Oil

Total Depth 2011

PRODUCTION

1st 24 hrs.-Nat.

1st 24 hrs. after shot

Gas Cu. Ft.

Dry Hole

Abandoned

Date

JUN 11 1941 19

S. J. LEWIS Scout