

KANSAS

Butler


Form 51-5M-7-40-Palace

Section 8 Township 25 Range 5-E

Well No. 198 Wilson

Company Cities Service Oil

NORTH Eldorado pool

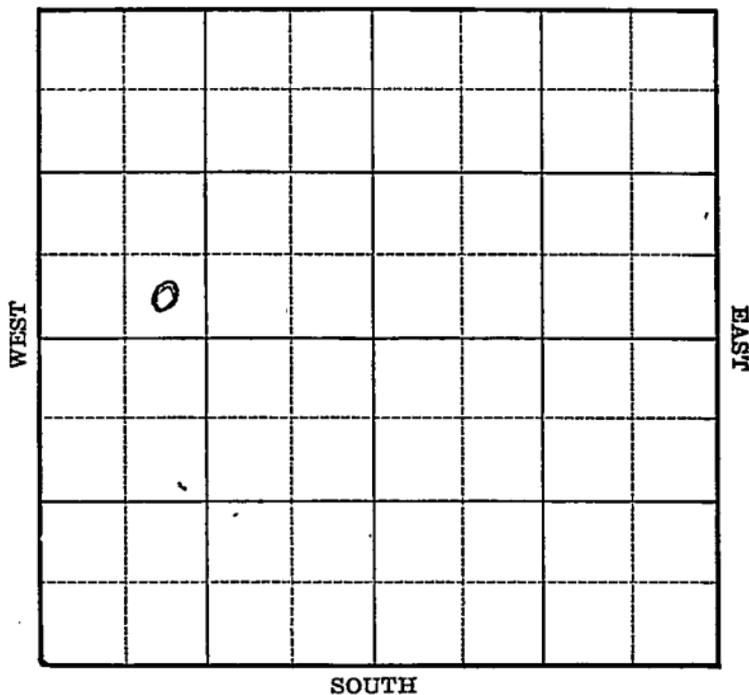

Sec. 8 Twp. 25 R. 5-~~H~~

Well No. #198 Wilson Farm


Cities Service Oil Company
(Eldorado)

_____ Ft. from N. Line

330 Ft. from S. Line

_____ Ft. from E. Line

990 Ft. from W. Line

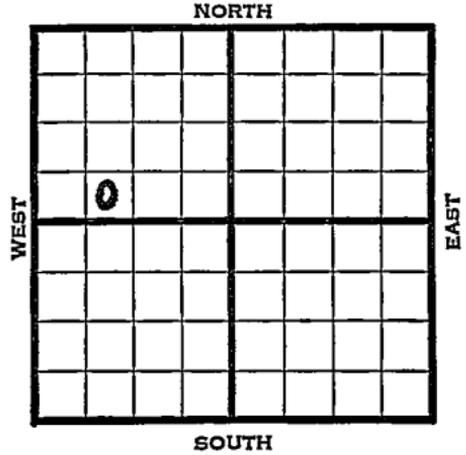

1941		REPORT
5/14	Drig.	698'
5/22	K.C.	1969-81' T.D. 7" - 1975'
		RUST.
5/28	"	
6/5	T.D.	2032' 2000 acid.
6/11	K.C.	1969'
		7" - 1975'
		T.D. 2032'
		2000 acid.
		Pump 66 oil & 70 water, potentia
		36. Gravity
		COMPLETED

