


KANSAS

Map No. _____ Sec. 8 Twp. 25 R. 5Well No. 161 Wilson Farm _____Empire Company _____

NORTH

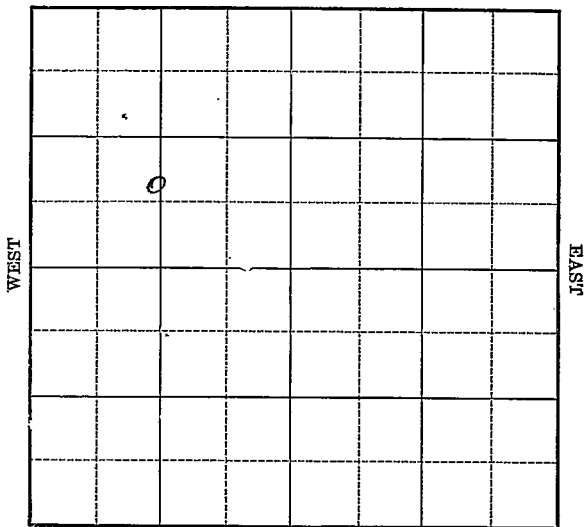

SOUTH

Location _____

Drilling Remarks _____

Rig Up _____

Drilling Remarks _____

RECORD

Cased _____ in. _____ ft.

Sand _____

Gas _____

Oil _____

Total Depth _____

PRODUCTION

1st 24 hrs. Nat. _____

1st 24 hrs. after shot _____

Gas _____ cu. ft.

Dry Hole _____

Abandoned _____

Map No. 1 Kansas Sec. 8 Twp. 25 R. 5

Well No. 161 Wilson Farm


Empire G. & F Company

_____ Ft. from N. Line

792 Ft. from S. Line

_____ Ft. from E. Line

1320 Ft. from W. Line

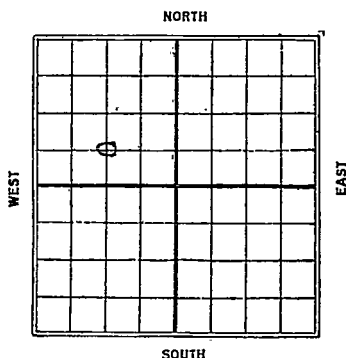

Date 1925

REPORT

12/23 Location

1926

1/4

1/60

1/37

2/4

2/10 S. & G. 715

Map No. **KANSAS** Sec. **8** Twp. **25** R. **5**

Well No. **166 Neldon**

Empire Oil & Co Company

Contractor

SECTION PLAT

Ft. from N. Line

792 Ft. from S. Line

Ft. from E. Line

1320 Ft. from W. Line

FIRST REPORTS

Location

Rig up

Drilling and Remarks:

RECORD

Cased _____ in., _____ ft.

Sand _____

Gas _____

Oil _____

Total Depth _____

PRODUCTION

1st 24 hrs. Nat. _____

1st 24 hrs. after shot _____

Gas _____ Cu. Ft.

Dry Hole _____

Abandoned _____

Date

DEC 23 1925

CHAS. L. SHERWOOD

192

Scout

Charley and Thome
2 # 160 wells on
this new quarter

Frank
Lamb

for my mistake this is
161.

Returned	
Cards	<i>MB</i>
Tracing	<i>MB</i>
France Map	<i>MB</i>
Scarborough Map	<i>MB</i>
Moody Map	<i>Normal map</i>
Scarborough Plat Book	
Moody Plat Book	

K14 KANSAS

Map No. Sec. 8 Twp. 25 R. 5

Well No. 161 Hildon

Empire Oil & Gas Co. Company

Contractor

COMPLETED

SECTION PLAT

Ft. from N. Line

79 Ft. from S. Line

Ft. from E. Line

1326 Ft. from W. Line

ABANDONED

	o		

Location

Rig up

Drilling and Remarks:

Dry & khd

20 715

RECORD

Cased in, ft.

Sand

Gas

Oil

Total Depth 715

PRODUCTION

1st 24 hrs. Nat.

1st 24 hrs. after shot

Gas Cu. Ft.

Dry Hole

Abandoned

Date

FEB 10 1926

192

CHAS. L. SHERWOOD

Scout