

SIDE ONE

STATE CORPORATION COMMISSION OF KANSAS
OIL & GAS CONSERVATION DIVISIONWELL COMPLETION OR RECOMPLETION FORM
ACO-1 WELL HISTORY

DESCRIPTION OF WELL AND LEASE

Operator: License # 4624
 Name Ted Uilhein Oil Properties
 Address PO Box 1330
 City/State/Zip Lawrence, Ks. 66044

Purchaser

Operator Contact Person Gerry Donally
 Phone 913-841-2294 or 843-1343

Contractor: License # 5650
 Name Kilby Drilg. Co. Inc.

Wellsite Geologist
 Phone

Designate Type of Completion

☒ New Well ☐ Re-Entry ☐ Workover

☐ Oil ☐ SWD ☐ Temp Abd
☐ Gas ☐ Inj ☐ Delayed Comp.
☒ Dry ☐ Other (Core, Water Supply etc.)

If OWWO: old well info as follows:

Operator
 Well Name
 Comp. Date Old Total Depth

WELL HISTORY

Drilling Method:

☒ Mud Rotary ☐ Air Rotary ☐ Cable

11/26/85 12/07/85 12-7-85
 Spud Date Date Reached TD Completion Date

1981
 Total Depth PBTD

Amount of Surface Pipe Set and Cemented at 43 feet
 Multiple Stage Cementing Collar Used? ☐ Yes ☒ No
 If yes, show depth set feet
 If alternate 2 completion, cement circulated
 from 43 feet depth to GL w/ 20 SX cmt

API NO. 15-073-23,499

County Greenwood

NE SE SE Sec. 26 Twp. 26 Rge. 12 ☒ East ☐ West

990 Ft North from Southeast Corner of Section
 330 Ft West from Southeast Corner of Section

(Note: Locate well in section plat below)


Lease Name Benson-Uilhein Well # 2

Field Name FANCY

Producing Formation ARBUCKLE

Elevation: Ground 1060 KB 1064

Section Plat

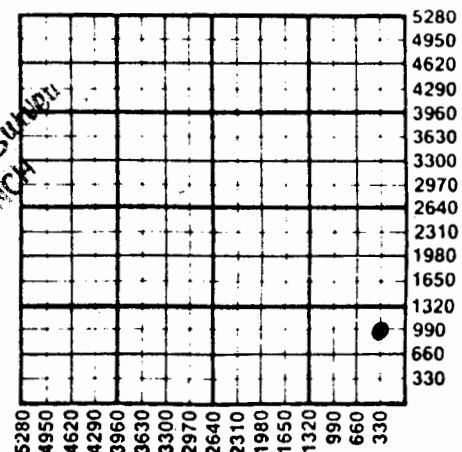

WATER SUPPLY INFORMATION

Disposition of Produced Water: ☐ Disposal
 Docket # ☐ Repressuring

Questions on this portion of the ACO-1 call:

Water Resources Board (913) 296-3717

Source of Water:

Division of Water Resources Permit #

☐ Groundwater Ft North from Southeast Corner
 (Well) Ft West from Southeast Corner of
 Sec Twp Rge ☐ East ☐ West

☐ Surface Water Ft North from Southeast Corner
 (Stream, pond etc) Ft West from Southeast Corner
 Sec Twp Rge ☐ East ☐ West

☐ Other (explain)
 (purchased from city, R.W.D. #)

INSTRUCTIONS: This form shall be completed in duplicate and filed with the Kansas Corporation Commission, 200 Colorado Derby Building, Wichita, Kansas 67202, within 90 days after completion or recompletion of any well. Rule 82-3-130 and 82-3-107 apply.

Information on side two of this form will be held confidential for a period of 12 months if requested in writing and submitted with the form. See rule 82-3-107 for confidentiality in excess of 12 months.

One copy of all wireline logs and drillers time log shall be attached with this form. Submit CP-4 form with all plugged wells. Submit CP-111 form with all temporarily abandoned wells.

