

16-26-14E



TYPE

AFFIDAVIT OF COMPLETION FORM

ACO-1 WELL HISTORY

Compt. _____

SIDE ONE

(Rules 82-3-130 and 82-3-107)

DOCKET NO. NP _____

This form shall be filed with the Kansas Corporation Commission, 200 Colorado Derby Building, Wichita, Kansas 67202, within ninety (90) days after the completion of a well, regardless of how the well was completed.

FOR INFORMATION REGARDING THE NUMBER OF COPIES TO BE FILED AND APPLICATIONS REQUIRING COPIES OF ACO-1 FORMS SEE PAGE TWO (2), SIDE TWO (2) OF THIS FORM.

F _____ Letter requesting confidentiality attached.

C _____ Attach ONE COPY of EACH wireline log run (i.e. electrical log, sonic log, gamma ray neutron log etc.)***Check here if NO logs were run ✓.

PLEASE FILL IN ALL INFORMATION. IF NOT AVAILABLE, INDICATE. IF INFORMATION LATER BECOMES AVAILABLE, SUBMIT BY LETTER.

LICENSE # 8842 EXPIRATION DATE 7/85

OPERATOR Three Falls Oil API NO. 15-207-24,956

ADDRESS Box 86, LeRoy, Kansas, 66857 COUNTY Woodson

FIELD wildcat

** CONTACT PERSON Helen Falls PROD. FORMATION _____
PHONE 316-964-2696 _____ Indicate if new pay.

PURCHASER Three Falls Oil LEASE Leon Swilley

ADDRESS Box 86, LeRoy, Kans. WELL NO. 1

WELL LOCATION NE/4 3807 NSEC-2600WSEC

DRILLING Kelly Down Drilling Co. inc. 3807 Ft. from North Line and


CONTRACTOR ADDRESS R.T. #1 P.O. Box 85 2600 Ft. from West Line of (E)
Neosho Falls, Kans. 66758 the NE 1/4 (Qtr.) SEC 16 TWP 26 RGE 14

PLUGGING Kelly Down Drilling

WELL PLAT

(Office Use Only)

CONTRACTOR ADDRESS Neosho Falls, Kans.

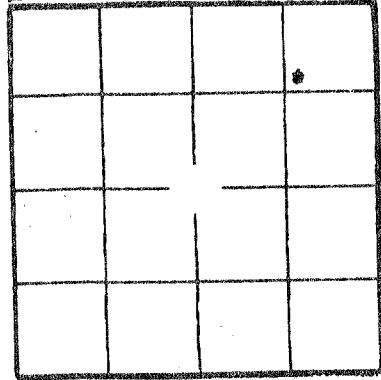

KCC ✓
KGS ✓
SWD/REP _____
PLG. _____
NGPA _____

TOTAL DEPTH 1420 PBTD _____

SPUD DATE 7/22/84 DATE COMPLETED 7/24/84

ELEV: GR _____ DF _____ KB _____

DRILLED WITH (CABLE) (ROTARY) (AIR) TOOLS.

DOCKET NO. OF DISPOSAL OR REPRESSURING WELL BEING USED TO DISPOSE OF WATER FROM THIS LEASE _____

Amount of surface pipe set and cemented 40' DV Tool Used? _____

TYPE OF COMPLETION THIS AFFIDAVIT APPLIES TO: (Circle ONE) - Oil, Shut-in Gas, Gas, Dry, Disposal, Injection, Temporarily Abandoned. If OWWO, indicate type of re-completion _____. Other completion _____. NGPA filing _____

ALL REQUIREMENTS OF THE STATUTES, RULES AND REGULATIONS PROMULGATED TO REGULATE THE OIL AND GAS INDUSTRY HAVE BEEN FULLY COMPLIED WITH.

A F F I D A V I T

Helen Falls, being of lawful age, hereby certifies that:
I am the Affiant, and I am familiar with the contents of the foregoing Affidavit.

Side TWO
 OPERATOR Three Falls Oil LEASE NAME Swilley SEC 16 TWP 26 RGE 14 (W)
 WELL NO 1

FILL IN WELL INFORMATION AS REQUIRED:

Show all important zones of porosity and contents thereof; cored intervals, and all drill-stem tests, including depth interval tested, cushion used, time tool open, flowing and shut-in pressures, and recoveries.

Show Geological markers, logs run, or other Descriptive information.

Formation description, contents, etc.	Top	Bottom	Name	Depth
<input checked="" type="checkbox"/> Check if no Drill Stem Tests Run.				
<input type="checkbox"/> Check if samples sent Geological Survey.				
Soil & Rock	0	12		
Lime	12	16		
Lime	16	367		
Shale w/Lime	367	546		
Lime	546	580		
Sandy Lime	580	636		
Shale & Lime	636	872		
Big Shale	872	994		
Lime w/Shale	994	1171		
Lime 20'	1171	1190		
Black Shale	1190	1199		
Lime 5'	1199	1205		
Black Shale	1205	1210		
Sandy Shale	1210	1270		
Black Shale	1270	1273		
Shale	1273	1285		
Black Shale	1285	1289		
Shale	1289	1324		
Black Shale	1324	1327		
Shale	1327	1360		
Sandy Shale	1360	1389		
Black Shale	1389	1420		
Total Depth	1420			

If additional space is needed use Page 2

Report of all strings set — surface, intermediate, production, etc. CASING RECORD (New) or (Used)

Purpose of string	Size hole drilled	Size casing set (in O.D.)	Weight lbs/ft.	Setting depth	Type cement	Sacks	Type and percent additives

LINER RECORD

PERFORATION RECORD

Top, ft.	Bottom, ft.	Sacks cement	Shots per ft.	Size & type	Depth interval

TUBING RECORD

Size	Setting depth	Packer set at

ACID. FRACTURE. SHOT. CEMENT SQUEEZE RECORD