

24-26-15E
per REC

STATE CORPORATION COMMISSION OF KANSAS
OIL & GAS CONSERVATION DIVISION
WELL COMPLETION OR RECOMPLETION FORM
ACO-1 WELL HISTORY

DESCRIPTION OF WELL AND LEASE

Operator: license # 5983
name Victor J. Leis
address P O BOX 223
City/State/Zip Yates Center, KS 66783

Operator Contact Person Vic Leis
Phone 316-825-2106

Contractor: license # 5367
name Double L Drilling Co.

Onsite Geologist None
Phone None

PURCHASER
Designate Type of Completion
 New Well Re-Entry Workover

Oil SWD Temp Abd
 Gas Inj Delayed Comp.
 Dry Other (Core, Water Supply etc.)

WO: old well info as follows:

Operator
Well Name
Comp. Date Old Total Depth

WELL HISTORY

Drilling Method: Mud Rotary Air Rotary Cable
2-27-84 12-31-84 1-4-85
Date Date Reached TD Completion Date
1120 1100
Total Depth PBTD

Depth of Surface Pipe Set and Cemented at 45 feet

Multiple Stage Cementing Collar Used? Yes No

If Yes, Show Depth Set feet

Alternate 2 completion, cement circulated
from feet depth to w/ SX cmt

API NO. 15 - 207-25,187

County Woodson

NE SE SE Sec 24 Twp 26 Rge 1615 XX East
(location)

1100 Ft North from Southeast Corner of Section
230 Ft West from Southeast Corner of Section
(Note: locate well in section plat below)


Lease Name Elmer Diver Well# 1

Field Name None

Producing Formation Bottesville

Elevation: Ground N/A KB

Section Plat

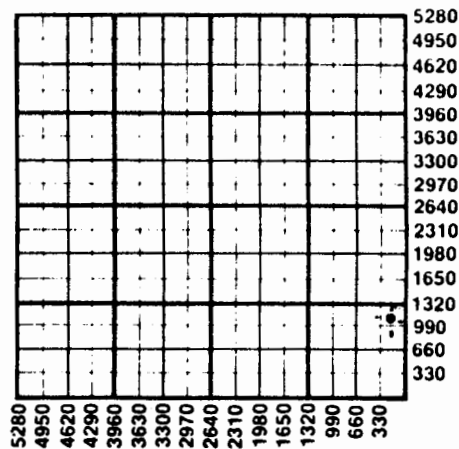

WATER SUPPLY INFORMATION

Source of Water:
Division of Water Resources Permit #

Groundwater Ft North From Southeast Corner and
(Well) Ft West From Southeast Corner of
Sec Twp Rge East West

Surface Water Ft North From Southeast Corner and
(Stream, Pond etc.) Ft West From Southeast Corner
Sec Twp Rge East West

Other (explain)
(purchased from city, R.W.D.#)

Disposition of Produced Water: Disposal Repressuring

Docket #

INSTRUCTIONS: This form shall be completed in duplicate and filed with the Kansas Corporation Commission, 200 Colorado Derby Building, Wichita, Kansas 67202, within 90 days after completion or recompletion of any well. Rules 82-3-130 and 82-3-107 apply.

Information on side two of this form will be held confidential for a period of 12 months if requested in writing and submitted with the form. See rule 82-3-107 for confidentiality in excess of 12 months.

One copy of all wireline logs and drillers time log shall be attached with this form. Submit CP-4 form with all plugged wells. Submit CP-111 form with temporarily abandoned wells.

Requirements of the statutes, rules, and regulations promulgated to regulate the oil and gas industry have been

Operator Name Victor J. Leis Lease Name Elmer Diver Well# 1 SEC 24 TWP. 26 RGE. 10 Ea We

WELL LOG

INSTRUCTIONS: Show important tops and base of formations penetrated. Detail all cores. Report all drill stem tests giving interval tested, time tool open and closed, flowing and shut-in pressures, whether shut-in pressure reached sta level, hydrostatic pressures, bottom hole temperature, fluid recovery, and flow rates if gas to surface during test. Attach extra sheet if more space is needed. Attach copy of log.

Drill Stem Tests Taken Yes No
 Samples Sent to Geological Survey Yes No
 Cores Taken Yes No

Formation Description
 Log Sample

Name	Top	Bottom
Soil	0	40
Sandy Shale	40	53
Broken Lime	53	92
Shale	92	
Lime	140	160
Shale	160	226
Broken Lime	226	246
Shale	246	323
Kansas City Lime	323	
Shale	491	592
Lime	592	632
Shale	632	723
Lime	723	743
Shale	743	770
Lime	770	790
Shale	790	798
Lime	798	828
Shale	828	830
Broken Sand (odor)	830	838
Shale	838	925
Sand	925	957
Shale	957	969
Gray Sand	969	1004
Shale	1004	
Black Shale	1047	
White Shale	1050	1072
Oil Sand	1072	1078
T.D.	1120	

CASING RECORD new used

Report all strings set - conductor, surface, intermediate, production, etc.

Purpose of string	size hole drilled	size casing set (in O.D.)	weight lbs/ft.	setting depth	type of cement	# sacks used	type and percent additives
Surface Pipe	9 7/8	6 5/8		45	Portland	11	
Long String	5 1/4	None					

PERFORATION RECORD

Acid, Fracture, Shot, Cement Squeeze Record

shots per foot	specify footage of each interval perforated	(amount and kind of material used)	Depth