

TYPE

AFFIDAVIT OF COMPLETION FORM

ACO-1 WELL HISTORY

SIDE ONE

Compt. 5-26-26

*Bill* ?1

Two (2) copies of this form shall be filed with the Kansas Corporation Commission, 200 Colorado Derby Building, Wichita, Kansas 67202, within thirty (30) days after the completion of a well, regardless of how the well was completed.

F)  Attach separate letter of request if the information is to be held confidential. If confidential, only file one copy. Information on Side One will be of public record and Side Two will then be held confidential.

C)  Applications must be made on dual completion, commingling, salt water disposal, injection and temporarily abandoned wells.

C)  Attach one copy only wireline logs (i.e. electrical log, sonic log, gamma ray neutron log, etc.). (Rules 82-2-105 & 82-2-125) KCC# (316) 263-3238.

LICENSE # 6190 EXPIRATION DATE 6/30/84

OPERATOR William G. Ash API NO. 15-173-20,640

ADDRESS 500 North Sagebrush COUNTY Sedgwick

Wichita, Kansas 67230 FIELD \_\_\_\_\_

\*\* CONTACT PERSON William G. Ash PROD. FORMATION Miss.Chat & Burg.Sd.

PHONE 316-733-5280

BUYER Mobil Oil Corp LEASE Vogt "B"

ADDRESS Box 900 WELL NO. 1 75' north

Dallas, Texas 75221 WELL LOCATION of NW SE SW

DRILLING CONTRACTOR Reynolds Drilling Co., Inc. 1065 Ft. from South Line and

ADDRESS 0201 College 1650 Ft. from West Line of

Winfield, Kansas 67156 the SW (Qtr.) SEC 5 TWP 26S RGE 2 (E)

PLUGGING CONTRACTOR \_\_\_\_\_

ADDRESS \_\_\_\_\_

TOTAL DEPTH 3525' PBTD \_\_\_\_\_

SPUD DATE 4-6-84 DATE COMPLETED 4-15-84

ELEV: GR 1432 DF 1435 KB 1437

DRILLED WITH ~~(CABLE)~~ (ROTARY) ~~(AIR)~~ TOOLS.

DOCKET NO. OF DISPOSAL OR REPRESSURING WELL BEING USED TO DISPOSE OF WATER FROM THIS LEASE \_\_\_\_\_

Amount of surface pipe set and cemented 212' DV Tool Used? \_\_\_\_\_

THIS AFFIDAVIT APPLIES TO: (Circle ONE) (Oil) Gas, Shut-in Gas, Dry, Disposal, Injection, Temporarily Abandoned, OWWO. Other \_\_\_\_\_

ALL REQUIREMENTS OF THE STATUTES, RULES AND REGULATIONS PROMULGATED TO REGULATE THE OIL AND GAS INDUSTRY HAVE BEEN FULLY COMPLIED WITH.


A F F I D A V I T

William G. Ash, being of lawful age, hereby certifies that:

I am the Affiant, and I am familiar with the contents of the foregoing Affidavit. The statements and allegations contained therein are true and correct.

JUN 19 1984

William G. Ash  
(Name)

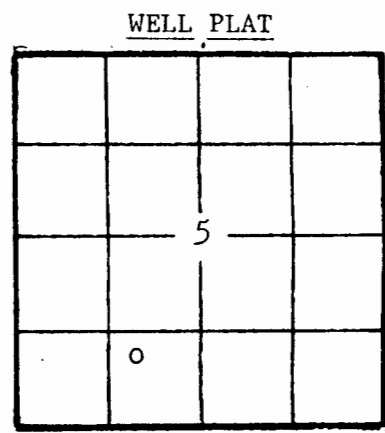

(Office Use Only)  
KCC \_\_\_\_\_  
KGS   
SWD/REP \_\_\_\_\_  
PLG. \_\_\_\_\_