

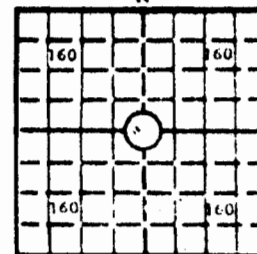
WELL COMPLETION REPORT AND
DRILLER'S LOGAPI No. 15 — 173 — 20,250
County Number WICHITA, BRANCH

State Geological Survey

S. 7 T. 26S. 2E E W

Loc. C SE SE NE

County Sedgwick

640 Acres
N

Locate well correctly

Elev.: Gr. 1419

DF. KB 1424

Operator

Sanders Oil Company

Address

910 Sutton Place Wichita, Kansas

Well No.

1

Lease Name

Matson

Footage Location

330 feet from (N) line 330 feet from (E) line

Principal Contractor

Brandt Drilling Co., Inc. Robert D. Gensch

Geologist

Spud Date

3-11-81

Date Completed

3-21-81

Total Depth

3439

P.B.T.D.

Directional Deviation

Oil and/or Gas Purchaser

Inland Crude Purchasing Corp.

CASING RECORD

Report of all strings set — surface, intermediate, production, etc.

Purpose of string	Size hole drilled	Size casing set (in O.D.)	Weight lbs/ft.	Setting depth	Type cement	Sacks	Type and percent additives
Surface	12 1/4"	8 5/8	24#	200	common	80	3% CaCl
Production	7 7/8	4 1/2		3438	common		

LINER RECORD

PERFORATION RECORD

Top, ft.	Bottom, ft.	Sacks cement	Shots per ft.	Size & type	Depth interval

TUBING RECORD

Size	Setting depth	Packer set at			

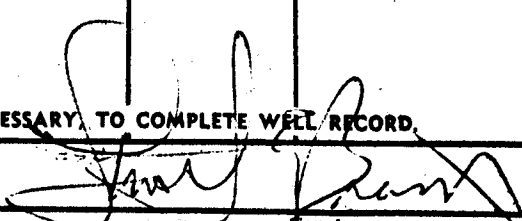
ACID, FRACTURE, SHOT, CEMENT SQUEEZE RECORD

Amount and kind of material used	Depth interval treated

INITIAL PRODUCTION

Date of first production		Producing method (flowing, pumping, gas lift, etc.)			
RATE OF PRODUCTION PER 24 HOURS		Oil	Gas	Water	Gas-oil ratio
		bbls.	MCF	bbls.	CFPB
Disposition of gas (vented, used on lease or sold)			Producing interval (s)		

INSTRUCTIONS: As provided in KCC Rule 82-2-125, within 90 days after completion of a well, one completed copy of this Driller's Log shall be transmitted to the State Geological Survey of Kansas, 4150 Monroe Street, Wichita, Kansas 67209. Copies of this form are available from the Conservation Division, State Corporation Commission, 245 No. Water, Wichita, Kansas 67202. Phone AC 316-522-2206. If confidential custody is desired, please note Rule 82-2-125. Driller's Logs will be on open file in the Oil and Gas Division, State Geological Survey of Kansas, Lawrence, Kansas 66044.

Operator Sanders Oil Company		DESIGNATE TYPE OF COMP.: OIL, GAS, DRY HOLE, SWDW, ETC.: oil	
Well No. 1	Lease Name Matson		
S 7 T 26S R 2E E W		Sedgwick County, Kansas	
WELL LOG		SHOW GEOLOGICAL MARKERS, LOGS RUN, OR OTHER DESCRIPTIVE INFORMATION.	
Show all important zones of porosity and contents thereof; cored intervals, and all drill-stem tests, including depth interval tested, cushion used, time tool open, flowing and shut-in pressures, and recoveries.			
FORMATION DESCRIPTION, CONTENTS, ETC.	TOP	BOTTOM	NAME
Soil	0	50	
Shaley lime	50	310	
Shale and Shells	310	1750	
Lime	1750	1982	
Shale	1982	2221	
Lime & shale	2221	2840	
Shale	2840	2907	
Lime	2907	3439	
RTD	3439		
USE ADDITIONAL SHEETS, IF NECESSARY, TO COMPLETE WELL RECORD.			
Date Received	 Signature Vice President, General Manager Title April 30, 1981 Date		

LS6911