

26-22 E

15-26-22 E

SE, SE

Water well at Petersburg, Kans., Bourbon Co.

Started Aug. 26, 1934

Completed Aug. 31, '34.

Drilled by Jack Cyr.


10-26-22 E

|                   |      |
|-------------------|------|
| soil              | 4    |
| clay              | 9    |
| sandstone -       | 14   |
| shale, blue       | 22   |
| lime, white,      | 27   |
| shale, gray       | 35   |
| Lime, white, hd.  | 60   |
| sh. blue          | 67   |
| lime, white, sft. | 80   |
| shale, lt         | 85   |
| lime, lt. hard    | 90   |
| sh. blue          | 108  |
| lime, white, hd.  | 130  |
| sh. blue          | 134  |
| lime, white, hard | 165  |
| shale, blue       | 181. |

Seven 40 gal. bailers per hour

water 27-35 2 1/2 B.  
80-85 3 1/2 B.

water stands 19-20'

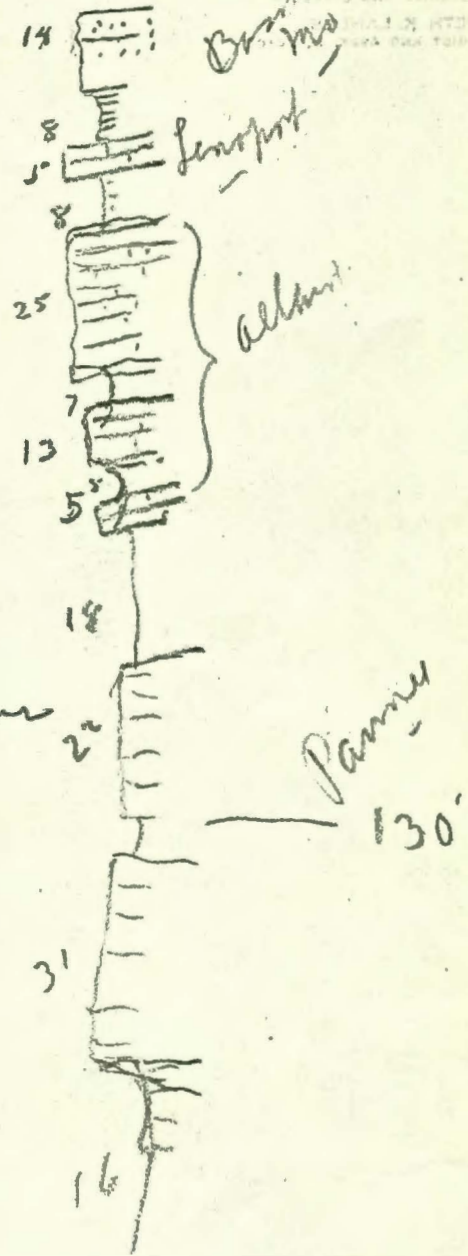

15-26-22E

mpg

Petersburg Well

Sec. 15 T. 26 S. R. 22 E.

Comp. 8-31-34

Loc. SEc SE

Driller:

County: Bourbon

T. D. 181'

# Formation

|              | Thickness | Depth |
|--------------|-----------|-------|
| black dirt   | 5         | 5     |
| clay, yellow | 4         | 9     |
| sandstone    | 5         | 14    |
| shale, blue  | 8         | 22    |
| lime, white  | 5         | 27    |
| shale, gray  | 8         | 35    |
| lime, white  | 25        | 60    |
| shale, blue  | 7         | 67    |
| lime, white  | 13        | 80    |
| shale, light | 5         | 85    |
| lime, white  | 5         | 90    |
| shale, blue  | 18        | 108   |
| lime, white  | 22        | 130   |
| shale, blue  | 4         | 134   |
| lime, white  | 31        | 165   |
| shale, blue  | 16        | 181   |

T. D.

Seven 40 gal. bailers per hour.

Water 27 to 35 2½ B  
80 to 85 3½ B

Water stands 19-20'.

15-26-22E

Company Claude Crowder

Sec. 15 T. 26 R. 22E

Farm Water Well

No.

Loc. SEc

County Bourbon

Total Depth

Comm. August 31, 1934 Comp.

Shot or Treated

Contractor Cyr Drilling Co.

Issued

Casing

|        |        |
|--------|--------|
| 20 in. | 10 in  |
| 15 1/2 | 8 1/4  |
| 12 1/2 | 6 5/8  |
| 13 3/8 | 5 3/16 |

|  |  |  |  |
|--|--|--|--|
|  |  |  |  |
|  |  |  |  |
|  |  |  |  |
|  |  |  |  |

Elevation

Production

Figures Indicate Bottom of Formation

|     |                 |     |
|-----|-----------------|-----|
| 4   | Soil Black      | 4   |
| 5   | Clay Yellow     | 5   |
| 9   | Sand Stone      | 9   |
| 14  | Shale Blue      | 14  |
| 22  | Lime White Soft | 22  |
| 27  | Shale Gray      | 27  |
| 35  | Lime White Hard | 35  |
| 60  | Shale Blue      | 60  |
| 67  | Lime White Soft | 67  |
| 80  | Shale Light     | 80  |
| 85  | Lime White Hard | 85  |
| 90  | Shale Blue      | 90  |
| 108 | Lime White Hard | 108 |
| 130 | Shale Blue      | 130 |
| 134 | Lime White Hard | 134 |
| 165 | Shale Blue      | 165 |

Gift From  
Claude Crowder