



SIDE ONE

15-26-23E

STATE CORPORATION COMMISSION OF KANSAS
OIL & GAS CONSERVATION DIVISIONWELL COMPLETION OR RECOMPLETION FORM
ACO-1 WELL HISTORY

DESCRIPTION OF WELL AND LEASE

Operator: License # 7097
Name American Shallow Development
Address 7633 E. 63rd Pl., Suite 420
City/State/Zip Tulsa, OK 74133

Purchaser n/a

Operator Contact Person Byron E. Brown
Phone 918/252-9541

Contractor: License # 5831
Name Mokat Drilling Company

Wellsite Geologist n/a
Phone

Designate Type of Completion

☒ New Well ☐ Re-Entry ☐ Workover
☐ Oil ☐ SWD ☐ Temp Abd
☐ Gas ☐ Inj ☐ Delayed Comp.
☒ Dry-Plugged ☐ Other (Core, Water Supply, etc.)

If OWWO: old well info as follows:

Operator
Well Name
Comp. Date Old Total Depth

WELL HISTORY

Drilling Method:

☐ Mud Rotary ☒ Air Rotary ☐ Cable

11/10/83 11/11/83 4/22/85
Spud Date Date Reached TD Completion Date
361'
Total Depth PBTD

Amount of Surface Pipe Set and Cemented at 20 feet
Multiple Stage Cementing Collar Used? ☐ Yes ☐ No
If yes, show depth set feet
If alternate 2 completion, cement circulated
from 20 feet depth to surface 12 SX cmt

API NO. 15-011-22-093

County Bourbon

C S/2 SW/4 Sec. 15 Twp. 26S Rge. 23 ☒ East
West

660 Ft North from Southeast Corner of Section
3960 Ft West from Southeast Corner of Section
(Note: Locate well in section plat below)


Lease Name Griffith Well # 32

Field Name n/a

Producing Formation

Elevation: Ground KB

Section Plat

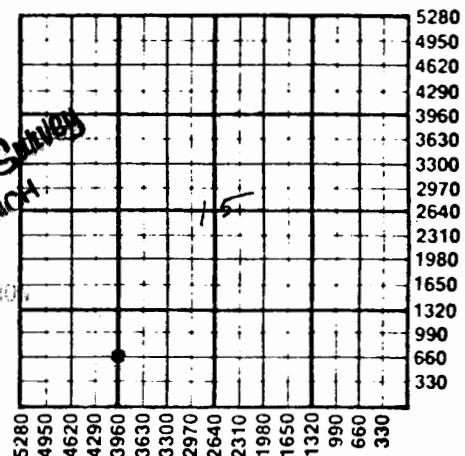

WATER SUPPLY INFORMATION

Disposition of Produced Water: ☐ Disposal
Docket # ☐ Repressuring

Questions on this portion of the ACO-1 call:

Water Resources Board (913) 296-3717

Source of Water:

Division of Water Resources Permit #

☐ Groundwater.....Ft North from Southeast Corner
(Well)Ft West from Southeast Corner of
Sec Twp Rge ☐ East ☐ West

☐ Surface Water.....Ft North from Southeast Corner
(Stream, pond etc).....Ft West from Southeast Corner
Sec Twp Rge ☐ East ☐ West

☐ Other (explain).....
(purchased from city, R.W.D. #)

INSTRUCTIONS: This form shall be completed in duplicate and filed with the Kansas Corporation Commission, 200 Colorado Derby Building, Wichita, Kansas 67202, within 90 days after completion or recompletion of any well. Rule 82-3-130 and 82-3-107 apply.

Information on side two of this form will be held confidential for a period of 12 months if requested in writing and submitted with the form. See rule 82-3-107 for confidentiality in excess of 12 months.

12-98-21

SIDE TWO

Operator Name American Shallow Development Lease Name..... Griffith Well #..... 32

Sec..... 15 Twp..... 26S Rge..... 23 ☒ East ☐ West County..... Bourbon

WELL LOG

INSTRUCTIONS: Show important tops and base of formations penetrated. Detail all cores. Report all drill stem tests giving interval tested, time tool open and closed, flowing and shut-in pressures, whether shut-in pressure reached static level, hydrostatic pressures, bottom hole temperature, fluid recovery, and flow rates if gas to surface during test. Attach extra sheet if more space is needed. Attach copy of log.

Drill Stem Tests Taken	☐ Yes	☐ No			
Samples Sent to Geological Survey	☐ Yes	☒ No			
Cores Taken	☒ Yes	☐ No			

	Top	Bottom	Formation Description		
			☐ Log	☒ Sample	
			Name	Top	Bottom
Soil	0	3			
Clay	3	9			
Lime	9	43			
Shale	43	95			
Lime	95	100			
Sandy Lime (oil odor)	100	109			
Shale	109	114			
Lime	114	123			
Shale	123	125			
Sandy Shale	125	131			
Sand (oil show)	131	140			
Sandy Shale	140	161			
Shale	161	256			
Sandy Shale	256	262			
Shale	262	267			
Sand	267	268			
Core	268	310			
Shale	310	314			
Sandy Shale	314	320			
Shale	320	361			

CASING RECORD ☒ New ☐ Used							
Report all strings set-conductor, surface, intermediate, production, etc.							
Purpose of String	Size Hole Drilled	Size Casing Set (in O.D.)	Weight Lbs/Ft.	Setting Depth	Type of Cement	#Sacks Used	Type and Percent Additives
Surface	6 1/2"	7"	17#	20'	Portland A	12	Calc. Chlor.

PERFORATION RECORD		Acid, Fracture, Shot, Cement Squeeze Record	
Shots Per Foot	Specify Footage of Each Interval Perforated	(Amount and Kind of Material Used)	Depth

TUBING RECORD			
Size	Set At	Packer at	Liner Run ☐ Yes ☐ No