



15-26-23E<sup>P1</sup>

STATE CORPORATION COMMISSION OF KANSAS  
OIL & GAS CONSERVATION DIVISION

WELL COMPLETION OR RECOMPLETION FORM  
ACO-1 WELL HISTORY

DESCRIPTION OF WELL AND LEASE

Operator: License # 7097  
Name American Shallow Development  
Address 7633 E. 63rd Pl. Suite 420  
City/State/Zip Tulsa, OK 74133

Purchaser n/a

Operator Contact Person Byron E. Brown  
Phone 918/252-9541

Contractor: License # 5831  
Name Mokat Drilling Company

Wellsite Geologist n/a  
Phone

Designate Type of Completion  
 New Well  Re-Entry  Workover  
 Oil  SWD  Temp Abd  
 Gas  Inj  Delayed Comp.  
 Dry -Plugged  Other (Core, Water Supply etc.)

If OWWO: old well info as follows:  
Operator  
Well Name  
Comp. Date Old Total Depth

WELL HISTORY

Drilling Method:  
 Mud Rotary  Air Rotary  Cable  
10/12/83 10/12/83 4/22/85  
Spud Date Date Reached TD Completion Date  
336  
Total Depth PBTD

Amount of Surface Pipe Set and Cemented at 20 feet  
Multiple Stage Cementing Collar Used?  Yes  No  
If yes, show depth set. feet  
If alternate 2 completion, cement circulated from 20 feet depth to surface 10 SX cmt

API NO. 15-011-22,092  
County Bourbon  
C SE/4 SW/4 15 26S 23  East  
Sec. Twp. Rge.  West

660 Ft North from Southeast Corner of Section  
3300 Ft West from Southeast Corner of Section  
(Note: Locate well in section plat below)


Lease Name Griffith Well # 33

Field Name

Producing Formation

Elevation: Ground KB

Section Plat

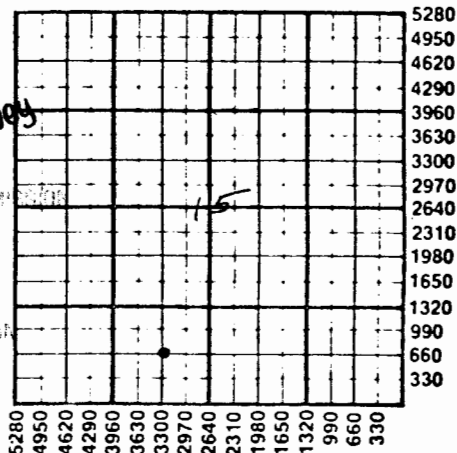

JUN 2 6 1985  
State Geological Survey  
WICHITA BRANCH  
JUN 2 5 1985  
CONSERVATION DIVISION  
Wichita, Kansas

WATER SUPPLY INFORMATION

Disposition of Produced Water:  Disposal  
Docket #  Repressuring

Questions on this portion of the ACO-1 call:

Water Resources Board (913) 296-3717

Source of Water:  
Division of Water Resources Permit #

Groundwater.....Ft North from Southeast Corner  
(Well) .....Ft West from Southeast Corner of  
Sec Twp Rge  East  West

Surface Water.....Ft North from Southeast Corner  
(Stream, pond etc).....Ft West from Southeast Corner  
Sec Twp Rge  East  West

Other (explain).....  
(purchased from city, R.W.D. #)

INSTRUCTIONS: This form shall be completed in duplicate and filed with the Kansas Corporation Commission, 200 Colorado Derby Building, Wichita, Kansas 67202, within 90 days after completion or recompletion of any well. Rule 82-3-130 and 82-3-107 apply.  
Information on side two of this form will be held confidential for a period of 12 months if requested in writing and submitted with the form. See rule 82-3-107 for confidentiality in excess of 12 months.

316-26-2

SIDE TWO

Operator Name American Shallow Development Lease Name Griffith Well # 33

Sec. 15 Twp. 26S Rge. 23  East  West County Bourbon

WELL LOG

INSTRUCTIONS: Show important tops and base of formations penetrated. Detail all cores. Report all drill stem tests giving interval tested, time tool open and closed, flowing and shut-in pressures, whether shut-in pressure reached static level, hydrostatic pressures, bottom hole temperature, fluid recovery, and flow rates if gas to surface during test. Attach extra sheet if more space is needed. Attach copy of log.

Drill Stem Tests Taken  Yes  No  
 Samples Sent to Geological Survey  Yes  No  
 Cores Taken  Yes  No

Formation Description  
 Log  Sample

	Top	Bottom
Soil	0	4
Lime	4	37
Shale	37	70
Sandy Shale	70	94
Lime (Oil odor 95)	94	108
Shale	108	113
Lime	113	120
Shale	120	123
Coal	123	124
Shale	124	126
Sand (oil show 128)	126	133
Sandy Shale	133	160
Shale	160	220
Sandy Shale	220	223
Shale	223	244
Lime	244	245
Shale	245	276

Name	Top	Bottom
Sandy Shale	276	288
Sand	288	296
Sandy Shale	296	300
Shale	300	336

CASING RECORD  New  Used  
 Report all strings set-conductor, surface, intermediate, production, etc.

Purpose of String	Size Hole Drilled	Size Casing Set (in O.D.)	Weight Lbs/Ft.	Setting Depth	Type of Cement	#Sacks Used	Type and Percent Additives
Surface	6 1/2"	7"	17#	20'	Portland A	10	none
.....	.....	.....	.....	.....	.....	.....	.....
.....	.....	.....	.....	.....	.....	.....	.....

PERFORATION RECORD		Acid, Fracture, Shot, Cement Squeeze Record	
Shots Per Foot	Specify Footage of Each Interval Perforated	(Amount and Kind of Material Used)	Depth
.....	.....	.....	.....
.....	.....	.....	.....
.....	.....	.....	.....
.....	.....	.....	.....

TUBING RECORD Size Set At Packer at Liner Run  Yes  No