

TYPE

AFFIDAVIT OF COMPLETION FORM

ACO-1 WELL HISTORY

Compt. \_\_\_\_\_

15-26-22c

SIDE ONE

(Rules 82-3-130 and 82-3-107)

This form shall be filed with the Kansas Corporation Commission, 200 Colorado Derby Building, Wichita, Kansas 67202, within ninety (90) days after the completion of a well, regardless of how the well was completed.

FOR INFORMATION REGARDING THE NUMBER OF COPIES TO BE FILED AND APPLICATIONS REQUIRING COPIES OF ACO-1 FORMS SEE PAGE TWO (2), SIDE TWO (2) OF THIS FORM.

- F Letter requesting confidentiality attached.
- C Attach ONE COPY of EACH wireline log run (i.e. electrical log, sonic log, gamma ray neutron log etc.)\*\*\*Check here if NO logs were run \_\_\_\_\_.

PLEASE FILL IN ALL INFORMATION. IF NOT AVAILABLE, INDICATE. IF INFORMATION LATER BECOMES AVAILABLE, SUBMIT BY LETTER.

LICENSE # 7097 EXPIRATION DATE June 30 yearly

OPERATOR Marco Farms d/b/a American Shallow Development API NO. 15-011-21,949

ADDRESS 7633, E. 63rd. Pl. Suite 420 COUNTY Bourbon

Tulsa, OK 74133 FIELD

\*\* CONTACT PERSON Byron E. Brown PROD. FORMATION Cattleman

PHONE 918/252-9541

PURCHASER Square Deal Oil Company LEASE O. Younggren

ADDRESS P.O. Box 883, RR #3 WELL NO. 4

Chanute, KS 66720 WELL LOCATION SE NW SW

DRILLING MOKAT Drilling Co. 1650 Ft. from S Line and

CONTRACTOR P.O. Box 590 990 Ft. from W Line of (E)

ADDRESS Chaney, KS 67333 the SW. (Qtr.) SEC 15 TWP 26S RGE 23E

PLUGGING - WELL PLAT (Office Use Only)


TOTAL DEPTH 365' PBTD

SPUD DATE 6/2/83 DATE COMPLETED 11/30/83

ELEV: GR 901.0 DF KB

DRILLED WITH (CABLE) (ROTARY) (AIR) TOOLS.

DOCKET NO. OF DISPOSAL OR REPRESSURING WELL BEING USED TO DISPOSE OF WATER FROM THIS LEASE CD 68349

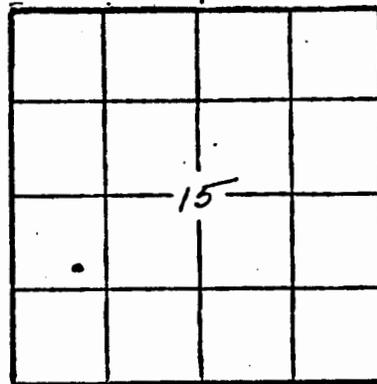

KCC   
KGS   
SWD/REP  
PLG.  
NGPA

Amount of surface pipe set and cemented 24' DV Tool Used?

TYPE OF COMPLETION THIS AFFIDAVIT APPLIES TO: (Circle ONE) - (Oil) Shut-in Gas, Gas, Dry, Disposal, Injection, Temporarily Abandoned. If OWWO, indicate type of re-completion. Other completion. NGPA filing

ALL REQUIREMENTS OF THE STATUTES, RULES AND REGULATIONS PROMULGATED TO REGULATE THE OIL AND GAS INDUSTRY HAVE BEEN FULLY COMPLIED WITH.

A F F I D A V I T

Byron E. Brown, being of lawful age, hereby certifies that:

I am the Affiant, and I am familiar with the contents of the foregoing Affidavit. The statements and allegations contained therein are true and correct