

TYPE

AFFIDAVIT OF COMPLETION FORM

ACO-1 WELL HISTORY

SIDE ONE

Compt. _____

Two (2) copies of this form shall be filed with the Kansas Corporation Commission, 200 Colorado Derby Building, Wichita, Kansas 67202, within thirty (30) days after the completion of a well, regardless of how the well was completed.

Attach separate letter of request if the information is to be held confidential. If confidential, only file one copy. Information on Side One will be of public record and Side Two will then be held confidential.

Applications must be made on dual completion, commingling, salt water disposal, injection and temporarily abandoned wells.

Attach one copy only wireline logs (i.e. electrical log, sonic log, gamma ray neutron log, etc.). (Rules 82-2-105 & 82-2-125) KCC# (316) 263-3238.

LICENSE # 5239

EXPIRATION DATE 6/30/83

OPERATOR PETRO-VALLEY SERVICES CORP.

API NO. 15-011-20,850

ADDRESS

P.O. Box 95

COUNTY BOURBON

BRONSON, KS 66716

FIELD SOUTH REDFIELD

** CONTACT PERSON W. J. WEATHERBIE

PROD. FORMATION TUCKER

PHONE 316-939-4987

PURCHASER NORTHWEST CENTRAL PIPELINE

LEASE R. RUSSELL

ADDRESS

FIRST NATL CENTER EAST, PO Box 25128

WELL NO. 2

OKLAHOMA CITY, OK 73125

WELL LOCATION NE 1/4 NE 1/4

DRILLING

C. & M. DRILLING

660 Ft. from NORTH Line and

CONTRACTOR

ADDRESS

PAOLA, KS 66071

660 Ft. from EAST Line of the NE (Qtr.) SEC 30 TWP 26 RGE 23 (E) (W).


PLUGGING

CONTRACTOR

ADDRESS

WELL PLAT

(Office Use Only)

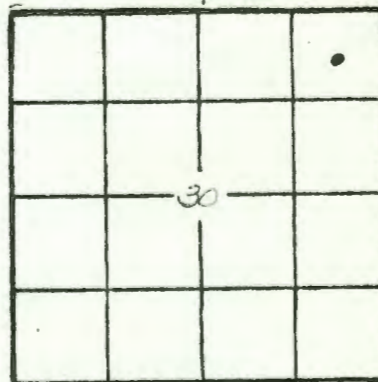

KCC

KGS ☒

SWD/REP

PLG.

TOTAL DEPTH 580'

PSTD

SPUD DATE 12/15/80 DATE COMPLETED 12/17/80

ELEV: GR 952

DF

KB

DRILLED WITH (CABLE) (ROTARY) (AIR) TOOLS.

JACKET NO. OF DISPOSAL OR REPRESSURING WELL BEING USED TO DISPOSE OF WATER FROM THIS LEASE

Amount of surface pipe set and cemented 605' DV Tool Used? NID

THIS AFFIDAVIT APPLIES TO: (Circle ONE) - Oil, Gas, Shut-in Gas, Dry, Disposal, Injection, Temporarily Abandoned, OWWO. Other

ALL REQUIREMENTS OF THE STATUTES, RULES AND REGULATIONS PROMULGATED TO REGULATE THE OIL AND GAS INDUSTRY HAVE BEEN FULLY COMPLIED WITH.

AFFIDAVIT

WENDELL J. WEATHERBIE, being of lawful age, hereby certifies that:

I am the Affiant, and I am familiar with the contents of the foregoing Affidavit. The statements and allegations contained therein are true and correct.

Wendell J. Weatherbie
(Name)

State Geological Survey
WICHITA BRANCH

SIDE TWO

OPERATOR

PETRO-VALLEY SERV. CORP. LEASE R. RUSSELL

SEC. 30 TWP. 26 RGE. 23

ACO-1 WELL HISTORY

(E)
(W)

FILL IN WELL INFORMATION AS REQUIRED:

WELL NO. 2

Show all important zones of porosity and contents thereof; cased intervals; and all down-hole tests, including depth interval tested, cushion used, time tool open, flowing and shut-in pressures, and recoveries.

SHOW GEOLOGICAL MARKERS, LOGS RUN, OR OTHER DESCRIPTIVE INFORMATION.

FORMATION DESCRIPTION, CONTENTS, ETC.	TOP	BOTTOM	NAME	DEPTH
Check if no Drill Stem Tests Run.				
Soil, Shale w/lime bks.	0	30		
Shale	30	67		
Lime w/shale	67	119		
Shale	119	172		
Lime	172	191		
Shale	191	198		
Lime	198	202		
Shale	202	467		
Core	67	87		
Shale	487	490		
Sand	490	514		
Shale	514	579		
Mississippi Chat	579	580		
T.D.	580			

State Geological Survey
WICHITA BRANCH

If additional space is needed use Page 2, Side 2

Report of all strings set — surface, intermediate, production, etc. CASING RECORD (New) or (Used)

Purpose of string	Size hole drilled	Size casing set (in O.D.)	Weight lbs./ft.	Setting depth	Type cement	Sacks	Type and percent additives
SURFACE	6 1/4"	7"		45'	Common	12	
PRODUCTION	6 1/4"	4 1/2"		561'	PORTLAND 'A'	100	50-50 POZ. 2% GEL 2 SKS. SALT

LINER RECORD

PERFORATION RECORD

Top, ft.	Bottom, ft.	Sacks cement	Shots per ft.	Size & type	Depth interval

TUBING RECORD

Size	Setting depth	Packer set at			
4 1/2"	5700'				