

GEOLOGICAL DEPARTMENT
UNION GAS CORPORATION
INDEPENDENCE, KANSAS

25-26-25E

Company The Southwestern Gas Company

S. T. R. 25-26-25
County Bourbon
State Kansas
Lease and Dugger #7
Well No.


Contractor Union Gas Corporation

Drilling Commenced Mar. 6, 1928 Drilling Completed Mar. 10, 1928.

Initial Production 176,160 cu. ft. Initial Rock Pressure 34#

Location 960' N. of S. line and 1200' E. of W. line of Section

Casing 8" 20'

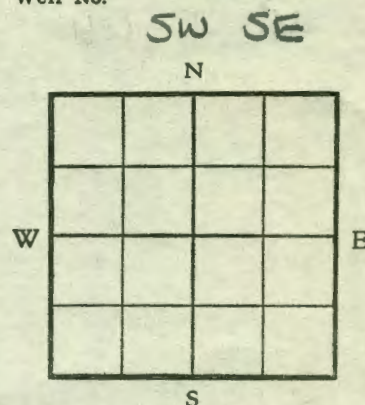

Driller's Record of Formations

3	soil	3	
4	yellow clay	7	
1	lime	8	
1	coal	9	
11	blue shale	20	
7	light shale	27	
6	dark shale	33	8 blrs. water per hr.
10	light shale	43	
1	lime	44	
4	dark shale	48	
20	light shale	68	
7	dark shale	75	
31	light shale	106	
1	lime	107	
24	dark shale	131	
15	light shale	146	
1	lime	147	
4	dark shale	151	
13	broken sand	164	no gas
8	white shale muddy	172	
5	light sandy shale	177	
11	dark shale	188	
2	sand	190	
4	sand	194	23,000 cu. ft. gas.
3	sand	197	46,080 " " "
2	sand	199	92,000 " " "
1	sand	200	113,040 " " "
1	sand	201	150,720 " " "
1	sand	203	168,000 " " "
1	sand	204	176,160 " " "
	T.D.		

3784
- 1200
2584 FEL
960 FSL

NAO 83
KGS ORL
2023