

**GEOLOGICAL DEPARTMENT  
UNION GAS CORPORATION  
INDEPENDENCE, KANSAS**

25-26-25 PL 2

Company **Anderson**

S. T. R. **25-26-25**  
County **Bourbon**  
State **Kansas**  
Lease and Well No. **#1 Burns**

Contractor

Drilling Commenced


Drilling Completed

Initial Production

Initial Rock Pressure

Location **NW corner of 35 $\frac{1}{2}$**

Casing

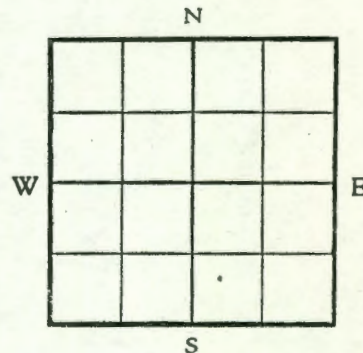

**Driller's Record of Formations**

surface	0
sandy clay yellow	17
grey shale	62
lime	53
black slate	56
grey shale	113
blue sandy shale	128
lime	130
sand gas	150
grey sandy shale	170
blue sand shale	184
sand gas	193
packer set at 118'	