

GEOLOGICAL DEPARTMENT  
 UNION GAS CORPORATION  
 INDEPENDENCE, KANSAS

26-26-25E  
 PL.

Company Southwestern Gas Company

S. T. R. 26-26-25  
 County Bourbon  
 State Kansas  
 Lease and Well No. G. W. Anderson #1


Contractor Union Gas Corporation

Drilling Commenced Jan. 26, 1928 Drilling Completed Jan. 20, 1928

Initial Production Initial Rock Pressure

Location 330' S. and 330' E. of NW corner of SW $\frac{1}{4}$

Casing 8" 20'

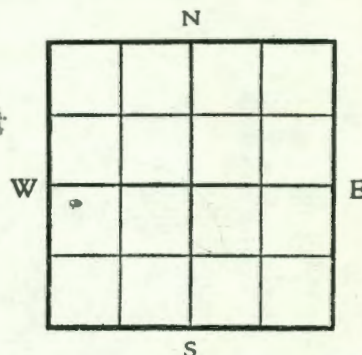

Driller's Record of Formations

0	soil	1	
4	yellow clay	5	
3	blue shale	8	
1	coal	9	
3	shale light	12	
5	coal dark shale	17	
1	shale	18	water
2	gravel shells	20	
1	shale light	21	
3	lime very firm	24	
5	slate black	29	
1	lime	30	
3	slate dark black	33	
39	shale light and dark	72	
2	lime	74	
56	shale dark	130	
15	light shale muddy	145	
12	shale dark	157	
8	sand	165	
5	shale light muddy	170	S.L.M.
5	sand	175	
	gas at 175		
6	sand	181	
14	shale white	195	
20	shale dark sandy	215	
8	sand gas	223	S.L.M.
	T.L.		

Geological Form 5