GEOLOGICAL DEPARTMENT

UNION GAS CORPORATION

INDEPENDENCE, KANSAS

26-26-25E

Company: Southwestern Gas Company

S. T. R.: 26-26-25
County: Bourbon
State: Kansas
Lease and Well No.: J. E. McCalment #

Contractor: Union Gas Corporation

Drilling Commenced: Mar. 31, 1928 Drilling Completed: Apr. 4, 1928

Initial Production: Dry

Initial Rock Pressure: NW

Location: 330' E. and 330' S. of NW corner of N½ of NE¼ of Sec.

Casing

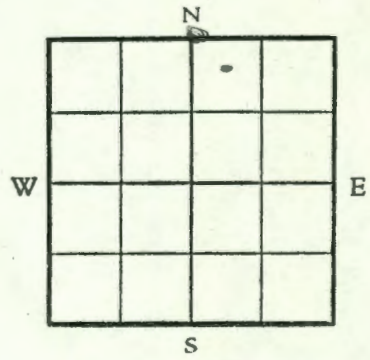

NW NE

Driller's Record of Formations

0	soil	2	
3	yellow clay	5	
10	lime black	15	
1	shale black-	16	
1	coal	17	
3	shale blue	20	
5	shale blue	25	
10	shale light	35	
5	shale dark	40	
10	shale light	50	
1	lime	51	
24	shale light	75	
12	shale dark	87	
26	shale light	113	
1	lime	114	
9	shale white	123	
17	shale dark	140	
15	shale light	155	
13	shale dark	168	
6	sand	174	show little gas
9	shale light	183	
13	shale dark	196	
61	sand	257	12 blrs. water
9	slate black	266	
4	shale white	270	
14	slate black	284	
6	sand dark	290	
1	coal	291	
7	shale black	298	
1	lime very fine	299	
3	lime	302	some water T.D.

Geological Form 3