

GEOLOGICAL DEPARTMENT  
UNION GAS CORPORATION  
INDEPENDENCE, KANSAS

26-26-25E  
PL.

Company Southwestern Gas Company

S. T. R. 26-26-25  
County Bourbon  
State Kansas  
Lease and Well No. J. T. Morris #1


Contractor Union Gas Corporation

Drilling Commenced Jan. 10, 1928      Drilling Completed Jan. 13, 1928

Initial Production 130,000 cu. ft. gas      Initial Rock Pressure

Location 760' E. and 600' S. of NW corner of SE $\frac{1}{4}$

Casing

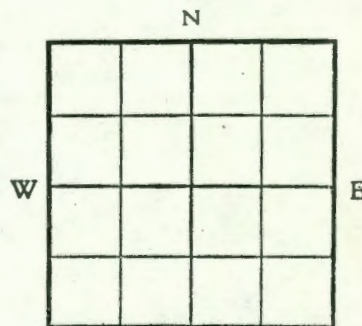

Driller's Record of Formations

1	soil black	1
4	clay yellow	5
4	shale blue	9
2	shells light water	11
2	shale or coal black	13
4	shells water	17
13	shale black	30
20	shale light	50
20	shale dark	70
35	shale light very muddy	105
18	shale dark	123
5	shale light	128
12	shale sandy	140
5	shale muddy little dark S.L.M.	145
3	lime sandy	148
12	sand little scum of oil	160
10	shale sandy	170
6	shale white S.L.M.	176
5	sand gas S.L.M.	181
2	sand gas 23,640	183
2	sand gas 28,992	185
2	sand gas 37,680	187
2	sand gas 130,000	189 S.L.M.
	T.D.	

NE NW SE

2773  
- 600  

---

2173 FSL

2670  
- 760  

---

1910 FEL

MAD 83  
KGS PRL  
2023

Geological Form 5