

GEOLOGICAL DEPARTMENT  
 UNION GAS CORPORATION  
 INDEPENDENCE, KANSAS

28-26-25C

Company      The Southwestern Gas Company

S. T. R.    23-26-25  
 County    Bourbon  
 State      Kansas  
 Lease and Well No.    A. W. Roy #2


Contractor    Union Gas Corporation

Drilling Commenced    May 23, 1928      Drilling Completed    May 25, 1928

Initial Production    54,000 cu. ft.      Initial Rock Pressure

Location      330' S. and 990' E. of NW corner of Section

Casing                      NE NW NW  
                                     N40 E3  
                                     265 PRL 2023

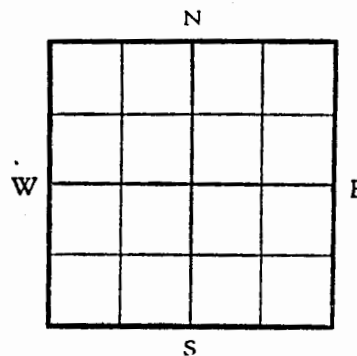

Driller's Record of Formations

2	soil	2	
9 $\frac{1}{2}$	clay	11 $\frac{1}{2}$	
6 $\frac{1}{2}$	lime	18	
7	dark shale	25	
61	light shale	86	
10	dark shale	96	
6	light shale	102	
22	dark shale	124	
10	light shale	134	
18	dark shale	152	
18	light shale	170	
9	dark shale	179	
8	light shale	187	
8	sandy shale	195	
12	light shale	207	
31	dark shale	238	
17	light shale	255	
20	dark shale	275	
5	sand light	280	
10	shale	290	S.L.K.
16	sand	306	gas

Geological Form 3