

GEOLOGICAL DEPARTMENT  
 UNION GAS CORPORATION  
 INDEPENDENCE, KANSAS

**36-26-J E**  
 PL.

Company **People State Bank**

S. T. R. **36-26-25**  
 County **Bourbon**  
 State **Kansas**  
 Lease and **People State Bank**  
 Well No. **#1**


Contractor **Hight et al**

Drilling Commenced **Sept. 3, 1928**      Drilling Completed

Initial Production      Initial Rock Pressure

Location **NW corner of SW<sub>4</sub> of NE<sub>4</sub>**

Casing

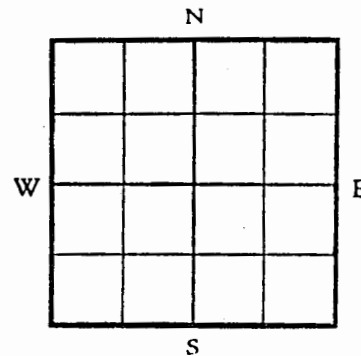

**Driller's Record of Formations**

soil	0	3
clay	3	5
lime	5	7
clay	7	10
coal	10	11
shale blue	11	14
lime black	14	18
shale light	18	20
lime white	20	26
shale light	26	40
lime white	40	47
shale white	47	90
lime white	90	98
shale white	98	120
shale dark	120	128
lime black	128	138
shale dark	138	150
shale light	150	156
lime white	156	160
sand	160	162
shale white	162	175
shale dark	175	210
salt sand	210	225 water