

**GEOLOGICAL DEPARTMENT
UNION GAS CORPORATION**

INDEPENDENCE, KANSAS

36-26-25E

Company **People State Bank**

36-26-25
S. T. R. **Bourbon**
County **Kansas**
State **State Bank #3**
Lease and
Well No.

Contractor **Hight et al**


Drilling Commenced **Sept. 21, 1928** Drilling Completed

Initial Production **150 W.**

Initial Rock Pressure

Location **SW corner of NE $\frac{1}{4}$ of SE $\frac{1}{4}$ of NW $\frac{1}{4}$**

Casing

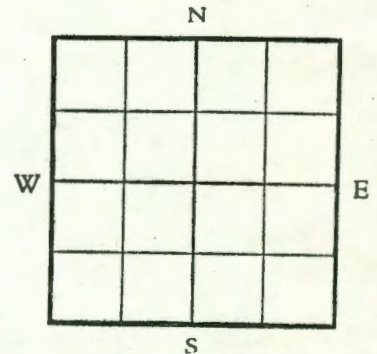

Driller's Record of Formations

soil	0	1
clay	1	12
boulders hard	12	17
coal	17	18
shale black	18	30
shale light	30	35
shale black	35	45
shale light	45	72
lime	72	76
shale black	76	85
shale light	85	90
sand	90	92
shale light	92	100
sand	100	102
shale light	102	130
lime light	130	135
shale light	135	148
lime	148	150
shale	150	160
sand gas	160	180
shale light	180	200
sand	200	210