

GEOLOGICAL DEPARTMENT  
UNION GAS CORPORATION  
INDEPENDENCE, KANSAS

36-26-25E  
PL.

Company **People State Bank**

S. T. R. 36-26-25  
County Bourbon  
State Kansas  
Lease and Well No. People State Bank #5


Contractor **Hight et al**

Drilling Commenced **Oct. 7, 1928** Drilling Completed

Initial Production **260 M.** Initial Rock Pressure

Location **approx. center of N $\frac{1}{2}$  of SE $\frac{1}{4}$  of NW $\frac{1}{4}$   
N $\frac{1}{2}$  SE $\frac{1}{4}$  NW $\frac{1}{4}$**

Casing

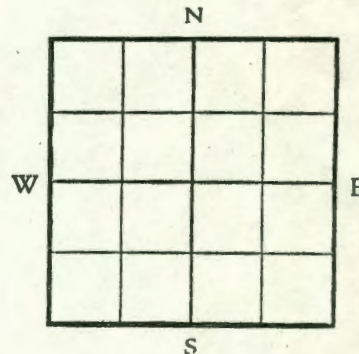

Driller's Record of Formations

soil	0	1
clay	1	5
lime	5	6
clay	6	8
lime	8	10
coal	10	11
shale black	11	20
shale light	20	30
lime	30	35
shale light	35	45
lime	45	51
shale light	51	78
lime	78	85
shale black	85	90
shale light	90	130
lime	130	132
shale brown	132	152
lime	152	154
shale white	154	161
sand gas	161	179
shale	179	208
sand	208	215