

7-27-11E *Grnd*

SIDE ONE

STATE CORPORATION COMMISSION OF KANSAS
OIL & GAS CONSERVATION DIVISION

WELL COMPLETION OR RECOMPLETION FORM
ACO-1 WELL HISTORY

DESCRIPTION OF WELL AND LEASE

Operator: License # 5370
Name .. Richard A. Soule
Address 822 E. River
City/State/Zip Burdett, KS, 67045

Purchaser.....
.....

Operator Contact Person Richard A. Soule
Phone .. 316-583-5287

Contractor: License # 5630
Name Kilby Drilling Co., Inc.

Wellsite Geologist.....
Phone.....

- Designate Type of Completion
- New Well Re-Entry Workover
- Oil SWD Temp Abd
- Gas Inj Delayed Comp.
- Dry Other (Core, Water Supply etc.)

If OWWO: old well info as follows:
Operator
Well Name
Comp. Date Old Total Depth.....

WELL HISTORY

Drilling Method:
 Mud Rotary Air Rotary Cable

..12/17/84 ..12/21/84. ...12/21/84
Spud Date Date Reached TD Completion Date

..1938.....
Total Depth PBDT

Amount of Surface Pipe Set and Cemented at 108 feet
Multiple Stage Cementing Collar Used? Yes No
If yes, show depth set.....feet
If alternate 2 completion, cement circulated
from...108...feet depth to...0...w/..50SX cmt

API NO. 15-...073-23,357... State Geological Survey
County.....Greenwood..... WICHITA BRANCH
NW.. NE.. NW.. Sec..7.. Twp.27..Rge..11.. East
 West

..4950... Ft North from Southeast Corner of Section
..3630... Ft West from Southeast Corner of Section
(Note: Locate well in section plat below)


Lease Name..Grundy.....'B'.....Well #...7...

Field Name...Willard.....

Producing Formation.....

Elevation: Ground.....KB.....

Section Plat

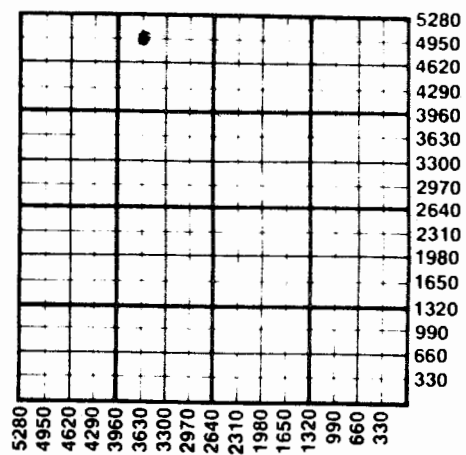

WATER SUPPLY INFORMATION

Disposition of Produced Water: Disposal
Docket # Repressuring

Questions on this portion of the ACO-1 call:
Water Resources Board (913) 296-3717

Source of Water:
Division of Water Resources Permit #.....

Groundwater.....Ft North from Southeast Corner
(Well)Ft West from Southeast Corner of
Sec Twp Rge East West

Surface Water 4290 Ft North from Southeast Corner
(Stream, pond etc) 3730 Ft West from Southeast Corner
Sec 7 Twp 27 Rge 11 East West

Other (explain).....
(purchased from city, R.W.D. #)

INSTRUCTIONS: This form shall be completed in duplicate and filed with the Kansas Corporation Commission, 200 Colorado Derby Building, Wichita, Kansas 67202, within 90 days after completion or recompletion of any well. Rule 82-3-130 and 82-3-107 apply.

Information on side two of this form will be held confidential for a period of 12 months if requested in writing and submitted with the form. See rule 82-3-107 for confidentiality in excess of 12 months. One copy of all wireline logs and drillers time log shall be attached with this form. Submit CP-4 form with all plugged wells. Submit CP-111 form with all temporarily abandoned wells.

SIDE TWO

Operator Name Richard A. Soule Lease Name..... Grundy, B Well #... 7...

Sec..... 7 Twp..... 27 Rge..... 11 East West County..... Greenwood.....

WELL LOG

INSTRUCTIONS: Show important tops and base of formations penetrated. Detail all cores. Report all drill stem tests giving interval tested, time tool open and closed, flowing and shut-in pressures, whether shut-in pressure reached static level, hydrostatic pressures, bottom hole temperature, fluid recovery, and flow rates if gas to surface during test. Attach extra sheet if more space is needed. Attach copy of log.

Drill Stem Tests Taken Yes No
Samples Sent to Geological Survey Yes No
Cores Taken Yes No

Formation Description
 Log Sample

Table with 3 columns: Name, Top, Bottom. Rows include Lime, Shale, and Lime Chert & TD with depth intervals.

CASING RECORD New Used
Report all strings set-conductor, surface, intermediate, production, etc.

Table with 8 columns: Purpose of String, Size Hole Drilled, Size Casing Set (in O.D.), Weight Lbs/Ft., Setting Depth, Type of Cement, #Sacks Used, Type and Percent Additives. Row 1: Surface P, 1 1/2, 3/8, 4, 108, Common, 50, 3% GAGE.

PERFORATION RECORD
Shots Per Foot | Specify Footage of Each Interval Perforated | Acid, Fracture, Shot, Cement Squeeze Record (Amount and Kind of Material Used) | Depth

Table with 4 columns: Shots Per Foot, Specify Footage of Each Interval Perforated, Acid, Fracture, Shot, Cement Squeeze Record (Amount and Kind of Material Used), Depth.

TUBING RECORD
Size Set At Packer at Liner Run Yes No

Date of First Production D7A Producing Method Flowing Pumping Gas Lift Other (explain).....

7-27-11E

MAR

Kilby Drilling Co., Inc.

DRILLING AND CORING CONTRACTING

ROTARY TOOLS

705 S. Pratt

Phone 316-625-2366

Yates Center, Kansas 66783

State Geological Survey
WICHITA BRANCH



61

Company - Richard A Soule

Farm - Grundy B

Well No. - 7

Drig. Comm. - Dec. 17, 1984

Drig. Comp. - Dec. 21, 1984

API# - 15-073-23,357

08' 8 5/8" surface set with 50 sks. cement / 3% CaCl

Cemented by Dowell Cementing Co.

Location

Greenwood County, Kansas

Sec. 7 Twp. 27 Rge. 11E

4950 FNL 3630 FWL

Figures indicate formation tops:

Formation	Depth
Soil	0
Lime	7
Shale	12
Lime	57
Shale	77
Lime	91
Shale	103
Lime	169
Shale	176
Lime	240
Shale	244
Lime	325
Shale	332
Lime	363
Shale	387
Lime	431
Shale	443
Lime	643
Shale	645
Lime	755
Shale	832
Lime	859
Shale	901
Lime	1072
Shale	1081
Lime	1120
Soft Lime	1143
Lime	1187
Shale	1272
Lime	1325
Shale	1345

Continued

Formation	Depth
Lime	1394
Shale	1400
Lime	1425
Shale	1436
Lime	1501
Shale	1504
Lime	1508
Shale	1535
Lime	1553
Shale	1569
Lime	1578
Shale	1587
Lime	1597
Shale	1601
Lime	1883
Shale	1887
Top Miss. Lime	1897
Lime Chert	9910
T.D. Rotary	1938

Completed dry

RECEIVED
STATE CORPORATION COMMISSION

MAR 1 1985

CONSERVATION DIVISION
Wichita, Kansas