

This form shall be filed in duplicate with the Kansas Corporation Commission, 200 Colorado Derby Building, Wichita, Kansas 67202, within ten days after the completion of the well, regardless of how the well was completed.

Attach separate letter of request if the information is to be held confidential. If confidential, only file one copy. Information on side one will be of public record and side two will then be held confidential.

Circle one: Oil, Gas, Dry, SWD, OWWO, Injection. Type and complete ALL sections. Applications must be filed for dual completion, commingling, SWD and injection.

Attach wireline logs (i.e. electrical log, sonic log, gamma ray neutron log, etc.). KCC # (316) 263-3238. (Rules 82-2-105 & 82-2-125)

OPERATOR Sunrise Oil Company *6964* API NO. 15-073-21,944

ADDRESS P.O. Box 447 COUNTY Greenwood

Fredonia, Kansas 66736 FIELD Wildcat

**CONTACT PERSON Bob Davis PROD. FORMATION Squirrel

PHONE 316-378-4406 LEASE Shinkle

PURCHASER Square Deal Oil Company WELL NO. 01-01

ADDRESS P.O. Box 883 WELL LOCATION NW, NE


Chanute, Kansas 66720 815 Ft. from N Line and

DRILLING Winter Drilling 1155 Ft. from E Line of

CONTRACTOR ADDRESS 618 West Ross the SEC. 9 TWP. 27 RGE. 13E

Nowata, Oklahoma 74048 WELL PLAT

PLUGGING CONTRACTOR ADDRESS State Geological Survey
WICHITA

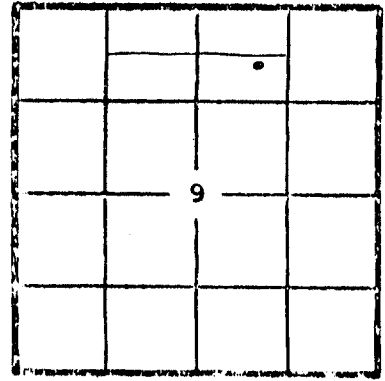

KCC
KGS
(Office Use)

TOTAL DEPTH 1385 PBD

SPOD DATE 5-21-81 DATE COMPLETED 5-22-81

ELEV: CR 1104 DF KB

DRILLED WITH (CABLE) (ROTARY) (AIR) TOOLS

Amount of surface pipe set and cemented 50 + DV Tool Used? No

A F F I D A V I T

STATE OF Kansas, COUNTY OF Wilson SS, I,

James M. Dickinson OF LAWFUL AGE, BEING FIRST DULY SWORN UPON HIS OATH,

DEPOSES THAT HE IS Owner (~~owner~~) (OF) Sunrise Oil Company

OPERATOR OF THE Shinkle LEASE, AND IS DULY AUTHORIZED TO MAKE

THIS AFFIDAVIT FOR AND ON THE BEHALF OF SAID OPERATOR, THAT WELL NO. 01-01 ON

SAID LEASE HAS BEEN COMPLETED AS OF THE 22nd DAY OF June, 1981, AND THAT

ALL INFORMATION ENTERED HEREIN WITH RESPECT TO SAID WELL IS TRUE AND CORRECT.

301-56-9

SIDE TWO

WELL LOG

Show all important zones of porosity and contents thereof; cored intervals, and all drill-stem tests, including depth interval tested, cushion used, time tool open, flowing and shut-in pressures, and recoveries.

SHOW GEOLOGICAL MARKINGS, LOGS NUM, OR OTHER DESCRIPTIVE INFORMATION.

FORMATION DESCRIPTION, CONTENTS, ETC.	TOP	BOTTOM	NAME	DEPTH
			9-27-13E	
Limstone and clay	0	7		
Shale	7	48		
Limestone, gray	48	66		
Shale, dark gray	66	69		
Limestone, light gray	69	71		
Shale, gray	71	75		
Shale, red	75	81		
Shale, light green	81	84		
Shale, red	84	86		
Shale, gray	86	103		
Shale, red	103	111		
Shale, gray	111	126		
Limestone, gray	126	136		
Shale, gray	136	156		
Limestone, gray	156	160		
Sand (Water)	160	167		
Shale, gray	167	176		
Sand (damp)	176	201		
Laminated sand	201	209		
Shale, gray	209	291		
Limestone, gray	291	294		
Shale, gray	294	299		
Limestone	299	304		
Sandy shale, light gray	304	311		
Sand (Water)	311	322		
Shale, gray	322	330		
Sand	330	339		
Shale, gray & Sandy shale	339	367		
Shale, gray	367	480		
Limestone	480	544		
Shale	544	623		
Limestone & shale	623	638		
Shale	638	715		
Limestone (heavy water)	715	760		
Sand	760	789		
Shale	789	806		

Report of all strings set — surface, intermediate, production, etc. CASING RECORD (New) or (Used)

Purpose of string	Size hole drilled	Size casing set (in O.D.)	Weight lbs/ft.	Setting depth	Type cement	Sacks	Type and percent additives
Surface	8 7/8	7	17	44.10	Portland	5	
Casing	6 1/4	4	9 1/2		Portland	160	5 sx gel

LINER RECORD

PERFORATION RECORD

Top, ft.	Bottom, ft.	Sacks cement	Shots per ft.	Size & type	Depth interval
			17	3 1/2 Glass	1304-1320
TUBING RECORD					
Size	Setting depth	Packer set at			
2 3/8	1310				

9-27-13E

OPERATOR Sunrise Oil Company LEASE NAME Shinkle 01-017 SEC. 9 TWP. 27 RGE. 13E

FILE IN WELL LOG AS REQUIRED:

Show all important zones of porosity and contents thereof; cased intervals, and all drill-stem tests, including depth interval tested, cushion used, time tool open, flowing and shut-in pressures, and recoveries.

SHOW GEOLOGICAL MARKERS, LOGS RUN, OR OTHER DESCRIPTIVE INFORMATION.

FORMATION DESCRIPTION, CONTENTS, ETC.	TOP	BOTTOM	NAME	DEPTH
Limestone	806	811		
Shale	811	834		
Limestone, Kansas City	834	934		
Shale	934	940		
Limestone	940	968		
Shale, black	968	974		
Limestone, Light brown	974	978		
Shale, medium gray	978	979		
Limestone, gray	979	1004		
Shale, dark gray	1004	1015		
Limestone, black to dark brown	1015	1016		
Shale, black (petro odor)	1016	1022		
Shale, gray	1022	1033		
Limestone, brown	1033	1051		
Shale, black (hard)	1051	1069		
Limestone	1069	1071		
Shale	1071	1091		
Limestone	1091	1112		
Shale	1112	1145		
Sand (oil in sample)	1145	1159		
Shale	1159	1170		
Sand (rainbow show in pit)	1170	1178		
Sandy shale	1178	1206		
Limestone	1206	1211		
Shale	1211	1214		
Limestone	1214	1245		
Shale	1245	1259		
Limestone	1259	1278		
Shale (hard)	1278	1281		
Limestone	1281	1287		
Shale	1287	1297		
Sandy shale	1297	1300		
Sand, Squirrel (odor)	1300	1335		
Shale	1335	1355		
Limestone	1355	1359		
Shale	1359	1372		
Sand, Cattleman	1372	1385 TD		