

9-27-13E *And*

This form shall be filed in duplicate with the Kansas Corporation Commission, 200 Colorado Derby Building, Wichita, Kansas 67202, within ten days after the completion of the well, regardless of how the well was completed.

Attach separate letter of request if the information is to be held confidential. If confidential, only file one copy. Information on side one will be of public record and side two will then be held confidential.

Circle one: Oil, Gas, Dry, SWD, OWWO, Injection. Type and complete ALL sections. Applications must be filed for dual completion, commingling, SWD and injection.

Attach wireline logs (i.e. electrical log, sonic log, gamma ray neutron log, etc.). KCC # (316) 263-3238. (Rules 82-2-105 & 82-2-125)

OPERATOR Sunrise Oil Company *16964*

API NO. 15-073-21,945

ADDRESS P.O. Box 447

COUNTY Greenwood

Fredonia, Ks. 66736

FIELD Wildcat

\*\*CONTACT PERSON Bob Davis

PROD. FORMATION Squirrel

PHONE 316-378-4406

LEASE Shinkle

PURCHASER Square Deal Oil Company

WELL NO. 01-02

ADDRESS P.O. Box 883

WELL LOCATION NW, NE

Chanute, Kansas 66720

1155 Ft. from N Line and

DRILLING CONTRACTOR Winter Drilling

1155 Ft. from E Line of

ADDRESS 618 West Ross


the SEC. 9 TWP. 27 RCR. 13E

Nowata, Oklahoma 74048

WELL PLAT

PLUGGING CONTRACTOR State Geological Survey

ADDRESS WICHITA BRANCH

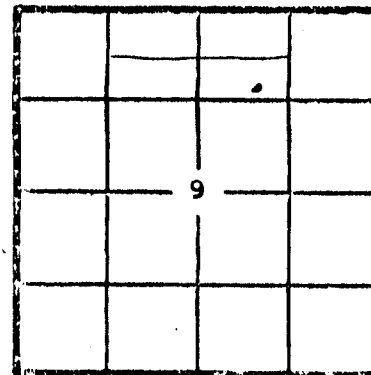

KCC   
KCS   
(Office Use)

TOTAL DEPTH 1387 PBD         

SPUD DATE 5-29-81 DATE COMPLETED 5-30-81

ELEV: CR 1103.6 DF          KB         

DRILLED WITH (CABLE) (ROTARY) (AIR) TOOLS

Amount of surface pipe set and cemented 50 DV Tool Used? no

A F F I D A V I T

STATE OF Kansas, COUNTY OF Wilson SS, I,         

James M. Dickinson OF LAWFUL AGE, BEING FIRST DULY SWORN UPON HIS OATH,

DEPOSES THAT HE IS owner (~~xxx~~)(OF) Sunrise Oil Company

OPERATOR OF THE Shinkle LEASE, AND IS DULY AUTHORIZED TO MAKE

THIS AFFIDAVIT FOR AND ON THE BEHALF OF SAID OPERATOR, THAT WELL NO. 01-02 ON

SAID LEASE HAS BEEN COMPLETED AS OF THE 30th DAY OF June, 19 81, AND THAT

ALL INFORMATION ENTERED HEREIN WITH RESPECT TO SAID WELL IS TRUE AND CORRECT.

381-56-P

**SIDE TWO**

**WELL LOG**

Show all important zones of porosity and contents thereof; cored intervals, and all drill-stem tests, including depth interval tested, cushion used, time test open, flowing and shut-in pressures, and recoveries.

SHOW GEOLOGICAL MARKERS, LOGS NO OR OTHER DESCRIPTIVE INFORMATION.

FORMATION DESCRIPTION, CONTENTS, ETC.	TOP	BOTTOM	NAME	DEPTH
			9-27-13E	

**ACID, FRACTURE, SHOT, CEMENT SQUEEZE RECORD**

Amount and kind of material used		Depth interval treated
60 sacks sand 125 bbls water		1302-1322
235 sacks Portland squeeze		1302-1322
Date of first production	Producing method (flowing, pumping, gas lift, etc.)	Gravity
	Pumping	23
RATE OF PRODUCTION PER 24 HOURS	OH	Gas
	1	MCF
	bbls.	Water %
		bbls.
Disposition of gas (vented, used on lease or sold)		Gas-oil ratio
		CF.
		Perforations
		20 @ 1302-1322

**Report of all strings set — surface, intermediate, production, etc. CASING RECORD (New) or (Used)**

Purpose of string	Size hole drilled	Size casing set (in O.D.)	Weight lbs/ft.	Setting depth	Type cement	Sacks	Type and percent additives
Surface	8 7/8	7	17	50	Portland	5	
Casing	6 1/4	4	9 1/2	1375	Portland	152	

**LINER RECORD**

**PERFORATION RECORD**

Top, ft.	Bottom, ft.	Sacks cement	Shots per ft.	Size & type	Depth interval
			1	3 1/2 glass	1302-1322

**TUBING RECORD**

Size	Setting depth	Packer set at

9-27-13E

PAGE TWO (Page Two)

ACU-1 WELL HISTORY

OPERATOR Sunrise Oil Company LEASE NAME Shinkle 01-02 SEC. 9 TWP. 27 RGE. 13E

## FILL IN WELL LOG AS REQUIRED:

Show all important zones of porosity and contents thereof, cored intervals, and all drill-stem tests, including depth interval tested, cushion used, time tool open, flowing and shut-in pressures, and recoveries.

SHOW GEOLOGICAL MARKERS, LOGS NUM, OR OTHER DESCRIPTIVE INFORMATION.

FORMATION DESCRIPTION, CONTENTS, ETC	TOP	BOTTOM	NAME	DEPTH
Limestone	0	8		
Shale	8	55		
Limestone	55	68		
Shale	68	71		
Limestone	71	73		
Shale	73	128		
Limestone	128	145		
Shale	145	161		
Sand (slight moisture)	161	170		
Shale	170	180		
Sand (moist)	180	201		
Shale	201	291		
Limestone	291	294		
Shale	294	301		
Limestone	301	303		
Sand	303	340		
Sandy shale	340	374		
Shale	374	484		
Limestone	484	494		
Shale	494	496		
Limestone	496	546		
Shale	546	715		
Limestone (water)	715	764		
Shale	764	765		
Sand	765	799		
Shale	799	809		
Limestone	809	813		
Sandy shale	813	839		
Limestone, Kansas City	839	938		
Shale	938	944		
Limestone	944	1007		
Shale	1007	1035		
Limestone	1035	1041		
Shale	1041	1097		
Limestone	1097	1113		
Shale	1113	1123		
Limestone	1123	1141		
Sand	1141	1155		
Shale	1155	1167		
Sand	1167	1192		
Shale	1192	1207		
Limestone	1207	1212		
Shale	1212	1215		
Limestone	1215	1242		
Shale	1242	1262		
Limestone	1262	1276		
Shale	1276	1284		
Limestone	1284	1290		
Shale	1290	1299		
Sandy Shale	1299	1302		
Sand, Squirrel	1302	1337		
Shale	1337	1371		
Sand, Cattleman	1371	1387 TD		