


Give All Information Completely
Make Required Affidavit
Mail or Deliver Report to:
Conservation Division
State Corporation Commission
211 No. Broadway
Wichita, Kansas

WELL PLUGGING RECORD

Neosho County, Sec. 4 Twp. 27S Rge. 18E (W)

NORTH

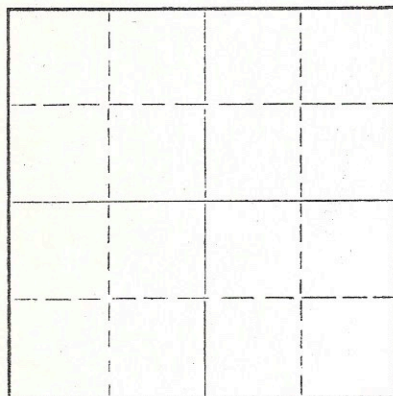

Locate well correctly on above
Section Plat

Location as "NE/CNW/SW" or footage from lines Kenneth C. Keas
Lease Owner Barker A Well No. 036
Lease Name Box 556, Chanute, Kansas 66720
Office Address oil
Character of Well (completed as Oil, Gas or Dry Hole) unknown
Date well completed 3-28-66 19
Application for plugging filed " 19
Application for plugging approved " 19
Plugging commenced " 19
Plugging completed " 19
Reason for abandonment of well or producing formation _____

If a producing well is abandoned, date of last production _____ 19
Was permission obtained from the Conservation Division or its agents before plugging was commenced? yes
Vic Simonic

Name of Conservation Agent who supervised plugging of this well _____ 741'
Producing formation _____ Depth to top _____ Bottom _____ Total Depth of Well _____ Feet
Show depth and thickness of all water, oil and gas formations.

OIL, GAS OR WATER RECORDS

CASING RECORD

FORMATION	CONTENT	FROM	TO	SIZE	PUT IN	PULLED OUT
	No log available					

Describe in detail the manner in which the well was plugged, indicating where the mud fluid was placed and the method or methods used in introducing it into the hole. If cement or other plugs were used, state the character of same and depth placed, from _____ feet to _____ feet for each plug set.

2" shot off at 550' and put in seven sacks cement. Set bridge at 150' and put in seven sacks cement. Set bridge at 25' and put in four sacks cement. Dirt to top.

W. R. ~~Simonic~~ (If additional description is necessary, use BACK of this sheet)

Name of Plugging Contractor Elsmore, Kansas License No. 60
Address _____

KANSAS NEOSHO
STATE OF Kenneth C. Keas COUNTY OF XXXXXXXXXXXX, ss. XXXXXX
(employee of owner) or (owner or operator) of the above-described well, being first duly sworn on oath, says: That I have knowledge of the facts, statements, and matters herein contained and the log of the above-described well as filed and that the same are true and correct. So help me God.

(Signature) _____
Box 556, Chanute, Kansas 66720

31 st

March

(Address) 66

SUBSCRIBED AND SWORN TO before me this _____ day of _____, 19____

10-22-67

Janet Bloomer

Notary Public.

My commission expires _____

