

STATE OF KANSAS  
STATE CORPORATION COMMISSION  
CONSERVATION DIVISION  
500 INSURANCE BUILDING  
212 NORTH MARKET  
WICHITA, KANSAS 67202

FORM CP-1

WELL PLUGGING APPLICATION FORM  
File One Copy

Lease Owner Kenneth Keas  
Address Box 556 Cherokee Kansas  
Lease (Farm Name) Elles Well No. 020T  
Well Location SW - NW - SE Sec. 4 Twp. 27 Rge. 18 (E) (W)  
County Neosho Field Name (If any) \_\_\_\_\_  
Total Depth 724' Oil Well  Gas Well \_\_\_\_\_ Input Well \_\_\_\_\_ SWD Well \_\_\_\_\_ D & A \_\_\_\_\_  
Was well log filed with application? \_\_\_\_\_ If not, explain: no log available

Date and hour plugging is desired to begin 7/22/66  
Plugging of the well will be done in accordance with the Rules and Regulations of the State Corporation Commission.

Name of company representative in charge of plugging operations Dean Ludlum  
Address Elmore Kansas  
Plugging Contractor W. R. Ludlum License No. 60  
Address Elmore Kansas


Invoice covering assessment for plugging this well should be sent to Kenneth Keas  
Box 556 Address Cherokee Kansas

and payment will be guaranteed by applicant.  
2" shut off at 600' and put in seven sacks cement. Set body at 150' and put in seven sacks cement. Set body at 25' and put in four sacks cement. Ditch to top  
Plugging started + finished 7/22/66  
Signed: Dean Ludlum Applicant or Acting Agent  
Date: 7/22/66

STATE OF KANSAS  
STATE CORPORATION COMMISSION

Give All Information Completely  
Make Required Affidavit  
Mail or Deliver Report to:  
Conservation Division  
State Corporation Commission  
212 North Market, Insurance Bldg.  
Wichita, Kansas

WELL PLUGGING RECORD

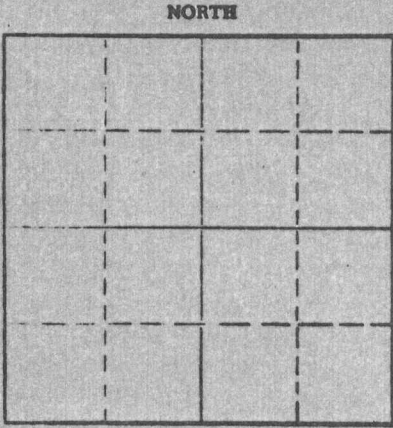

Locate well correctly on above  
Section Plat

Neosho County, Sec. 4 Twp. 27/S. Rge. 18E (E) (W)

Location as "NE/CNWSWA" or footage from lines SW NW SE  
Lease Owner Kenneth C. Keas  
Lease Name Elks Well No. 020T  
Office Address Box 556, Chanute, Kansas 66720  
Character of Well (completed as Oil, Gas or Dry Hole) oil  
Date well completed unknown 19\_\_  
Application for plugging filed 7-22-66 19\_\_  
Application for plugging approved " 19\_\_  
Plugging commenced " 19\_\_  
Plugging completed " 19\_\_  
Reason for abandonment of well or producing formation \_\_\_\_\_

If a producing well is abandoned, date of last production \_\_\_\_\_ 19\_\_  
Was permission obtained from the Conservation Division or its agents before plugging was commenced? yes

Name of Conservation Agent who supervised plugging of this well Vic Simoncic  
Producing formation \_\_\_\_\_ Depth to top \_\_\_\_\_ Bottom \_\_\_\_\_ Total Depth of Well 724 Feet  
Show depth and thickness of all water, oil and gas formations.

OIL, GAS OR WATER RECORDS

CASING RECORD

FORMATION	CONTENT	FROM	TO	SIZE	PUT IN	PULLED OUT
No log available						

Describe in detail the manner in which the well was plugged, indicating where the mud fluid was placed and the method or methods used in introducing it into the hole. If cement or other plugs were used, state the character of same and depth placed, from \_\_\_\_\_ feet to \_\_\_\_\_ feet for each plug set.

2" shot off at 600' and put in seven sacks cement. Set bridge at 150' and put in seven sacks cement. Set bridge at 25' and put in four sacks cement. Dirt to top.

(If additional description is necessary, see BACK of this sheet)  
Name of Plugging Contractor W. R. Ludlum  
Address Elsmore, Kansas License No. 60

STATE OF KANSAS COUNTY OF NEOSHO  
Kenneth C. Keas (employer/owner) or (agent/contractor) of the above-described

well, being first duly sworn on oath, says: That I have knowledge of the facts, statements, and matters herein contained and the log of the above-described well as filed and that the same are true and correct. So help me God.

(Signature) [Signature]  
Box 556, Chanute, Kansas 66720  
(Address)

SUBSCRIBED AND SWORN TO before me this 25th day of July, 19 66

My commission expires 10-22-67 Janet Bloomer Notary Public.