

~~19 27 25~~

UNION NATIONAL BANK BLDG WICHITA, KANSAS

Plotted
T.W.T.

Location. SW NW SW
990' fr NL 330' fr W.L. SW $\frac{1}{4}$


Sec. 20 T. 27 R. 2E

Casing Record.

20" 10" 1493 Farm. Rimel
15 $\frac{1}{2}$ " 8 $\frac{1}{2}$ " Compy. E.F. Jones.
12 $\frac{1}{2}$ " 65/8" Contr.
905 53/16" Comm. 8-15-30
Total Depth. 3400 Shot Quarts Between.
Correspondence Regarding This Well Should be Referred To.

County. Sedgwick
No. 1

Comp. 10-1-30

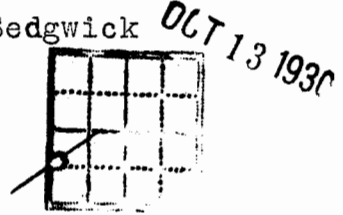

Elevation.

Figures Indicate Bottom of Formations.

Initial Production, Dry

Date Issued 10-11-30

Formation	Depth	Formation	Depth	Formation	Depth.
soil	12	lime white	1290	lime	2590
clay	25	lime	1310	lime	2670
slate	85	slate grey	1410	Missing slate	2675
lime	95	sdv lime 3BWPHR	1425	slate	2760
slate	170	lime 1415	1460	broken lime	2770
lime	175	slate	1470	slate	2795
slate	190	lime	1475	slate	2880
lime	500	sdv lime	1480	slate and shells	
slate	525	LOBV let hole fill up			2890
lime slate	605	lime	1490	slate	2910
red rock	620	water did not shut		lime	2920
LBW 620 lime	640	off		slate	2950
slate	650	slate grey	1535	red rock	2955
lime	660	slate	1555	slate	2960
slate	685	lime	1580	chat	2975
lime	710	lime	1600	1st sh oil	2970
slate	720	UR 10" 1493-1558		lime HFW	2983 2983
limb.	730	slate	1625	lime	3170
slate	745	lime shell	1626	slate sdv	3175
shells and slate	780	slate	1640	slate and shells	3212
lime	800	lime	1655	shale blk	3241
slate	860	slate	1670	sdv shale	3246
lime	910	lime	1680	shale blk	3255
shale	915	slate	1695	slate	3266
shale	920	lime	1705	show oil	3267
lime	940	slate	1735	sdv lime	3277
slate	975	slate	1750	more oil some wtr	
lime	985	lime	1755		3269
slate	1010	slate	1775	lime	3302
lime	1015	lime	1785	slate	3308
slate	1040	slate	1790	sand	3341
lime	1045	lime	1810	slate	3345
slate	1055	slate	1860	C.M. 3312-3331	
lime	1060	lime	1885	10" corrected sand	
slate	1085	lime	1930	line measure	
slate grey	1130	slate	1950	slate	3350
lime	1135	lime	1970	sand	3367
slate grey	1145	slate	1995	shale grey	3371
sdv lime 4BWPHR	1155	LBWPHR 1930		sand	3380
slate grey	1160	slate	2030	lime	3400
slate	1190	lime LBWPHR	2040	T.D.	
lime	1210	slate sdv	2095		
slate	1225	slate	2160		
lime	1230	lime	2170		
slate	1235	slate	2180		
lime	1240	lime	2225		
lime white	1260	slate	2330		
slate blue	1270	lime	2345		
		slate	2505		