

19-27-22 E

PI



STATE CORPORATION COMMISSION OF KANSAS
OIL & GAS CONSERVATION DIVISION

WELL COMPLETION OR RECOMPLETION FORM
ACO-1 WELL HISTORY

DESCRIPTION OF WELL AND LEASE

Operator: license # 5602
name N. & B. ENTERPRISES
address BOX 884
CHANUTE, KS 66720
City State/Zip

Operator Contact Person J. R. BURRIS
Phone 316-365-3181

Contractor: license # 5677
name J. R. BURRIS DRILLING

Wellsite Geologist
Phone

Designate Type of Completion

☒ New Well ☐ Re-Entry ☐ Workover

☒ Oil ☐ SWD ☐ Temp Abd
☐ Gas ☐ Inj ☐ Delayed Comp.
☐ Dry ☐ Other (Core, Water Supply etc.)

TWO: old well info as follows:

Operator
Well Name
Comp. Date Old Total Depth

WELL HISTORY

Drilling Method: ☒ Mud Rotary ☐ Air Rotary ☐ Cable

AN 3, 85 JAN 8, 85 JAN 20, 85
Spud Date Date Reached TD Completion Date

669!...
Total Depth BPTD

Amount of Surface Pipe Set and Cemented at 20! feet

Multiple Stage Cementing Collar Used? ☐ Yes ☒ No

If Yes, Show Depth Set feet

Alternate 2 completion, cement circulated

From feet depth to w/ SX cmt

API NO. 15 - 011-22, 444

County BOURBON
NW NE SW
S. 1 (location) Sec. 19 Twp. 27 Rge. 22 West

2420 Ft North from Southeast Corner of Section
3520 Ft West from Southeast Corner of Section
(Note: locate well in section plat below)


Lease Name SHIREMAN Well# 6-D

Field Name HEPLER

Producing Formation TUCKER

Elevation: Ground KB

Section Plat

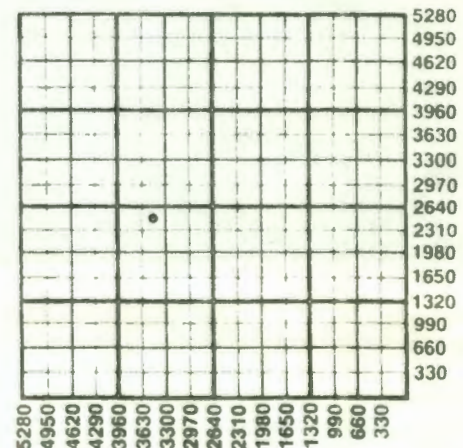

WATER SUPPLY INFORMATION

Source of Water:

Division of Water Resources Permit #

☐ Groundwater. Ft North From Southeast Corner and
(Well) Ft West From Southeast Corner of
Sec Twp Rge ☐ East ☐ West

☐ Surface Water. Ft North From Southeast Corner and
(Stream, Pond etc.) Ft West From Southeast Corner
Sec Twp Rge ☐ East ☐ West

☐ Other (explain)
(purchased from city, R.W.D.#)

Disposition of Produced Water: ☐ Disposal
☐ Repressuring

Docket #

INSTRUCTIONS: This form shall be completed in duplicate and filed with the Kansas Corporation Commission, 200 Colorado Derby Building, Wichita, Kansas 67202, within 90 days after completion or recompletion of any well. Rules 82-3-130 and 82-3-107 apply.

Information on side two of this form will be held confidential for a period of 12 months if requested in writing and submitted with the form. See rule 82-3-107 or confidentiality in excess of 12 months.

One copy of all wireline logs and driller's time log shall be attached with this form. Submit CP-4 form with all plugged wells. Submit CP-111 form with temporarily abandoned wells.

Operator Name N. & B. ENTERPRISES..... Lease Name SHIREMAN Well# 6-D SEC 19. TWP. 27. RGE. 22.

☒ East
☐ West

WELL LOG

INSTRUCTIONS: Show important tops and base of formations penetrated. Detail all cores. Report all drill stems giving interval tested, time tool open and closed, flowing and shut-in pressures, whether shut-in pressure reached static level, hydrostatic pressures, bottom hole temperature, fluid recovery, and flow rates if gas to surface during test. Attach extra sheet if more space is needed. Attach copy of log.

Drill Stem Tests Taken
Samples Sent to Geological Survey
Cores Taken

☐ Yes ☒ No
☐ Yes ☒ No
☐ Yes ☒ No

Formation Description
☒ Log ☐ Sample

Name	Top	Bottom
soil & clay	0	16
shale w/ lime breaks	16	645
sand	645	650
shale	650	669

NOT AVAILABLE

TUBING RECORD size set at packer at		Liner Run ☐ Yes ☐ No	
Date of First Production	Producing method ☐ flowing ☒ pumping ☐ gas lift ☐ Other (explain)		
Estimated Production Per 24 Hours	Oil 2 Bbls	Gas MCF	Water 5 Bbls Gas-Oil Ratio CFPB

METHOD OF COMPLETION

PRODUCTION INTERVAL

Disposition of gas: ☒ vented☐ sold☐ used on lease☐ open hole ☒ perforation☐ other (specify)☐ Dually Completed.☐ Commingled

CASING RECORD

☒ new☐ used

Report all strings set - conductor, surface, intermediate, production, etc.

Purpose of string	size hole drilled	size casing set (in O.D.)	weight lbs/ft.	setting depth	type of cement	# sacks used	type and percent additives
surface	11"	6"	6.4	20'	portland	10	none
long string	5 1/2"	2 7/8"	6.5	669'	portland	circulate to top	none

PERFORATION RECORD

Acid, Fracture, Shot, Cement Squeeze Record

shots per foot	specify footage of each interval perforated	(amount and kind of material used)	Depth
1	645-650 (6 holes)	100 gallons acid - 40 sacks sand w/ brine 150 bbls	