

30-27-22E0

JAN 18 1986

STATE CORPORATION COMMISSION OF KANSAS
OIL & GAS CONSERVATION DIVISION

RECEIVED
WELL COMPLETION OR RECOMPLETION FORM
ACO-1 WELL HISTORY

DESCRIPTION OF WELL AND LEASE

Operator: License # 9755
Name Advanced Recovery
Address P.O. Box 5143
Englewood, Colorado
City/State/Zip 80155

Purchaser... Eureka Crude

Operator Contact Person Fred Haddenhorst
Phone 303-790-0250

Contractor: License # 6056
Name Black Diamond

Wellsite Geologist G.B. French II
Phone 316-365-6712

Designate Type of Completion

- New Well
- Re-Entry
- Workover
- Oil
- Gas
- Dry
- SWD
- Inj
- Other (Core, Water Supply etc.)
- Temp Abd
- Delayed Comp.

If OWWO: old well info as follows:

Operator
Well Name
Comp. Date Old Total Depth.....

WELL HISTORY

Drilling Method:

- Mud Rotary
- Air Rotary
- Cable

10-29-84 10-30-84
Spud Date Date Reached TD Completion Date
640 635
Total Depth PBTD

Amount of Surface Pipe Set and Cemented at... feet
Multiple Stage Cementing Collar Used? Yes No
If yes, show depth set..... feet
If alternate 2 completion, cement circulated
from..... feet depth to..... w/..... SX cmt

API NO. 15-027-21296

County... Woodson

NE.. NE. Sec. 30. Twp 27. Rge. 22. East West

3134 Ft North from Southeast Corner of Section
1889 Ft West from Southeast Corner of Section
(Note: Locate well in section plat below)


Lease Name Albert Elmer Well # N2

Field Name Hepler

Producing Formation Tucker

Elevation: Ground.....KB.....

Section Plat

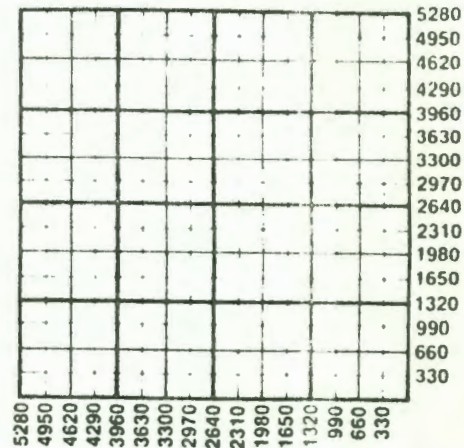

JAN 30 1985

WATER SUPPLY INFORMATION

Disposition of Produced Water: Disposal Repressuring
Docket #

Questions on this portion of the ACO-1 call:
Water Resources Board (913) 296-3717

Source of Water:
of Water Resources Permit #.....

- Groundwater.....Ft North from Southeast Corner (Well)Ft West from Southeast Corner of Sec Twp Rge East West
- Surface Water.....Ft North from Southeast Corner (Stream, pond etc).....Ft West from Southeast Corner Sec Twp Rge East West
- Other (explain).....
(purchased from city, R.W.D. #)

RECEIVED
STATE CORPORATION COMMISSION
OIL & GAS CONSERVATION DIVISION
Wichita, Kansas

INSTRUCTIONS: This form shall be completed in duplicate and filed with the Kansas Corporation Commission, 200 Colorado Derby Building, Wichita, Kansas 67202, within 90 days after completion or recompletion of any well. Rule 82-3-130 and 82-3-107 apply. Information on side two of this form will be held confidential for a period of 12 months if requested in writing and submitted with the form. See rule 82-3-107 for confidentiality in excess of 12 months. One copy of all wireline logs and drilling time logs shall be attached with this form.

SIDE TWO

Operator Name Advanced Recovery Lease Name Albert Elmer Well #.....

Sec. 30 Twp. 27 Rge. 22 East West County Woodson

WELL LOG

INSTRUCTIONS: Show important tops and base of formations penetrated. Detail all cores. Report all drill stem tests giving interval tested, time tool open and closed, flowing and shut-in pressures, whether shut-in pressure reached static level, hydrostatic pressures, bottom hole temperature, fluid recovery, and flow rates if gas to surface during test. Attach extra sheet if more space is needed. Attach copy of log.

Drill Stem Tests Taken Yes No
 Samples Sent to Geological Survey Yes No
 Cores Taken Yes No

Formation Description
 Log Sample

Name Top Bottom

FEB 13 1985
 State Geological Survey
 WICHITA BRANCH

CASING RECORD <input type="checkbox"/> New <input checked="" type="checkbox"/> Used							
Report all strings set-conductor, surface, intermediate, production, etc.							
Purpose of String	Size Hole Drilled	Size Casing Set (in O.D.)	Weight Lbs/Ft.	Setting Depth	Type of Cement	#Sacks Used	Type and Percent Additives
Surface	12"	7"	15#	20'	50/50poz	12	
Long String	5 1/8"	2 7/8"	7.5	635'	50/50poz	65	
PERFORATION RECORD				Acid, Fracture, Shot, Cement Squeeze Record			
Shots Per Foot	Specify Footage of Each Interval Perforated			Amount and Kind of Material Used			Depth
4	578-588			4000# 12/30 sand			
TUBING RECORD							
Size	Set At	Packer at	Liner Run	<input type="checkbox"/> Yes <input type="checkbox"/> No			