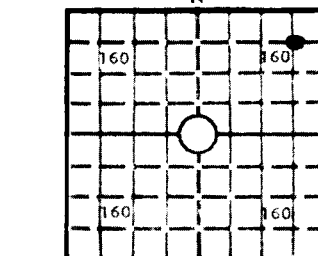


KANSAS

WELL COMPLETION REPORT AND
DRILLER'S LOGState Geological Survey 27 R. 19 E
WICHITA BRANCH
Loc. NE 1/4 NE 1/4

API No. 15 — County — Number —

County Neosho640 Acres
N

Locate well correctly

Elev.: Gr. _____

DF _____ KB _____

Operator <u>Petro-American, Inc.</u>			
Address <u>P.O. Box 793</u>			
Well No. <u>#1</u>	Lease Name <u>Stevens</u>		
Footage Location <u>160</u> feet from (N) (S) line <u>160</u> feet from (E) (W) line			
Principal Contractor <u>Petro-American</u>		Geologist	
Spud Date <u>8/11/80</u>	Date Completed <u>8/12/80</u>	Total Depth <u>806</u>	P.B.T.D.
Directional Deviation		Oil and/or Gas Purchaser	

CASING RECORD

Report of all strings set — surface, intermediate, production, etc.

Purpose of string	Size hole drilled	Size casing set (in O.D.)	Weight lbs/ft.	Setting depth	Type cement	Sacks	Type and percent additives
<u>Surface</u>	<u>5 1/4"</u>	<u>6"</u>		<u>25'</u>	<u>bulk</u>		<u>no additives</u>

LINER RECORD

PERFORATION RECORD

Top, ft.	Bottom, ft.	Sacks cement	Shots per ft.	Size & type	Depth interval

Size	Setting depth	Packer set at			

ACID, FRACTURE, SHOT, CEMENT SQUEEZE RECORD

Amount and kind of material used	Depth interval treated

INITIAL PRODUCTION

Date of first production <u>not yet set up to produce</u>		Producing method (flowing, pumping, gas lift, etc.)			
RATE OF PRODUCTION PER 24 HOURS	Oil bbls.	Gas bbls.	Water bbls.	Gas-oil ratio	CFPB
Disposition of gas (vented, used on lease or sold)			Producing interval(s)		

INSTRUCTIONS: As provided in KCC Rule 82-2-125, within 90 days after completion of a well, one completed copy of this Drillers Log shall be transmitted to the State Geological Survey of Kansas, 4150 Monroe Street, Wichita, Kansas 67209. Copies of this form are available from the Conservation Division, State Corporation Commission, 245 No. Water, Wichita, Kansas 67202. Phone AC 316-522-2206. If confidential custody is desired, please note Rule 82-2-125. Drillers Logs will be on open file in the Oil and Gas Division, State Geological Survey of Kansas, Lawrence, Kansas 66044.

Operator		DESIGNATE TYPE OF COMP.: OIL, GAS, DRY HOLE, SWDW, ETC.:
Well No.	Lease Name	
S _____ T _____ R _____ E _____ W		

WELL LOG			SHOW GEOLOGICAL MARKERS, LOGS RUN, OR OTHER DESCRIPTIVE INFORMATION.	
Show all important zones of porosity and contents thereof; cored intervals, and all drill-stem tests, including depth interval tested, cushion used, time tool open, flowing and shut-in pressures, and recoveries.				
FORMATION DESCRIPTION, CONTENTS, ETC.	TOP	BOTTOM	NAME	DEPTH
<div>USE ADDITIONAL SHEETS, IF NECESSARY, TO COMPLETE WELL RECORD.</div>				

Date Received	Signature
	Title
	Date