


PLAT AND CERTIFICATE OF INJECTION WELL LOCATION AND SURROUNDING ACREAGES

Operator Jimmy Razook LOCATION OF WELL:
 Lease Parks 3340 feet from South section line
 Well # # 5 650 feet from East section line
 County Butler Section 27, T 27 S, R 5 ~~East~~/West

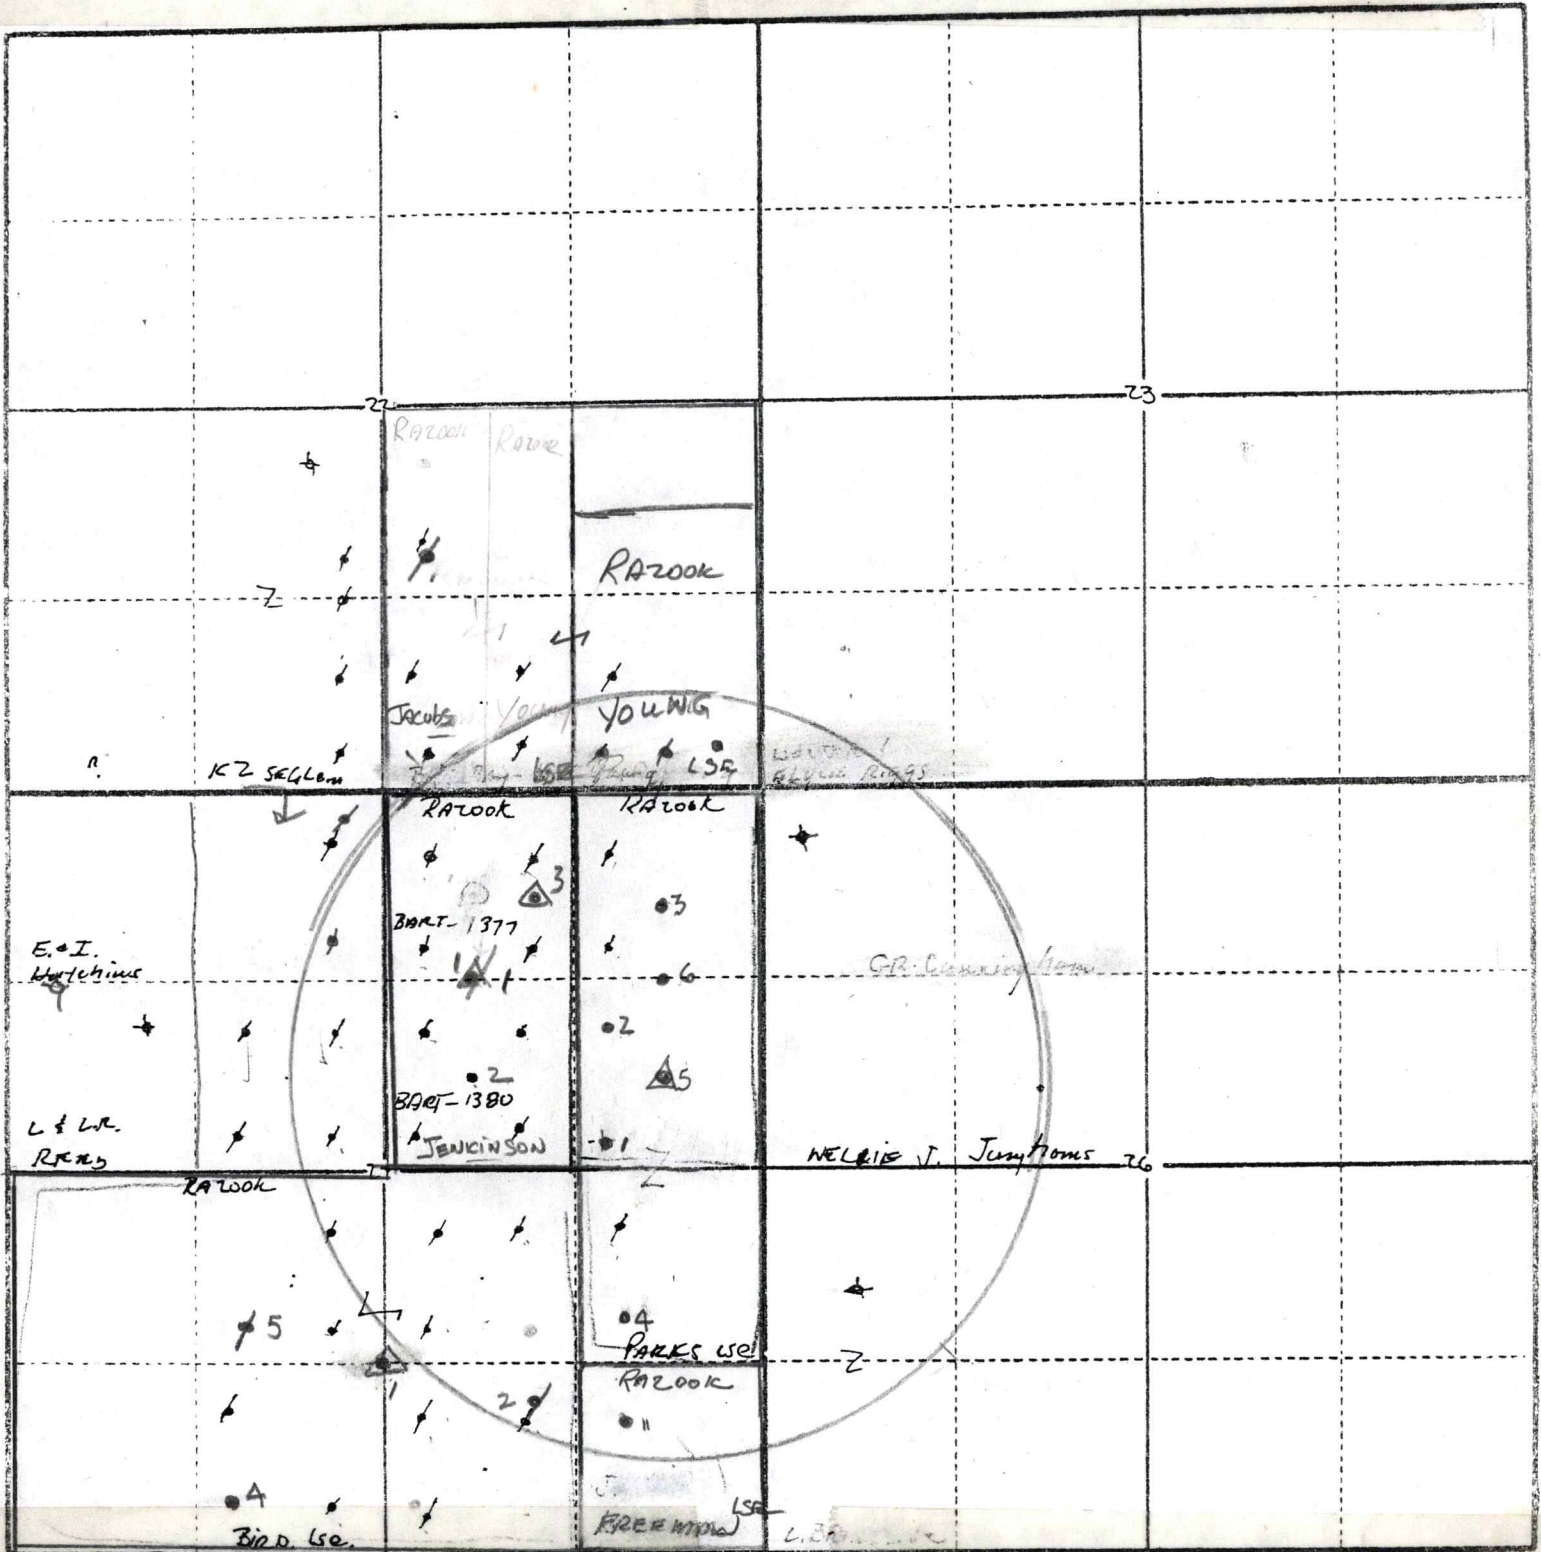

applicant well producing well
 D & A well other injection well
 plugged producer F. W. Morgan water supply well wsw plugged injection well temporarily abandoned well ta

The undersigned hereby certifies that he/~~she~~ is a duly authorized agent for Jimmy Razook, and that all of the information shown herein is true, complete and correct to the best of his/her knowledge.

Signature of Duly Authorized Agent

Subscribed and sworn to before me this 29th day of June, 19 90.

Notary Public

My Commission Expires: _____