

Source: Original record
9/29/34. 357

GEOLOGICAL DEPARTMENT
UNION GAS CORPORATION
INDEPENDENCE, KANSAS

Company J. F. Campbell

S. T. R. 34-27-16
County Wilson
State Kansas
Lease and Campbell #8
Well No.

Contractor W. D. Wilson

Drilling Commenced 3/27/30


Drilling Completed 4/9/30

Initial Production

Initial Rock Pressure

Location Center of SE $\frac{1}{4}$ of the SE $\frac{1}{4}$

Casing
8 $\frac{1}{2}$ " 9"
6 $\frac{3}{4}$ " 541' (pulled)
2" 863'
3/4" 838'

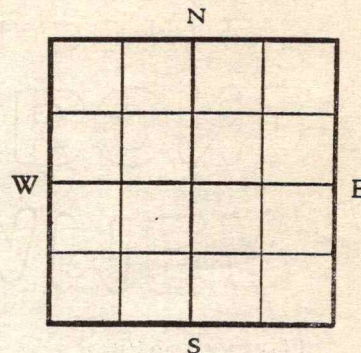

Driller's Record of Formations

soil	8	8
lime	37	45
shale mud	108	150
lime	20	170
shale	115	285
lime	13	298
shale	7	305
lime	2	307
shale	23	330
lime	10	340
shale	25	365
lime	87	452
black slate	3	455
lime	8	463
dark shale	5	468
lime	22	490
shale	8	498
lime	42	540
dark shale	70	610
lime	5	615
shale	15	630
lime 30'	7	637
white shale	13	650
lime 30'	15	665
white shale	5	670
sand	15	685
light shale	75	760
lime 40'	25	785
dark shale	39	824
lime 20'	17	841
black slate	6	847 gas
lime 5'	6	853
black slate	7	860 gas
white shale	3	863 T.D.

2 x 6 $\frac{1}{2}$ " Packer set at 837'
Cooper Seat set at 838'
Cage set at 839'
2 x 26" Perforated pipe set at 841'
22' 6" of 2" Anchor set below perforated pipe.
Total 2" tubing 863'
Total 3/4 tubing 838'
9 $\frac{1}{2}$ " Drive Pipe 9'
No record of 1" return pipe on well log