
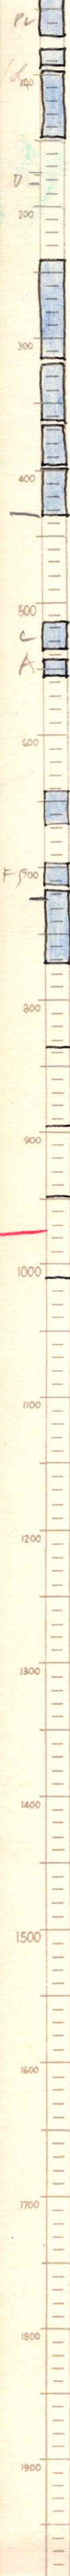


4 Wilson,
 Clara Peterson, 3
 Ridge Gas Co.
 Range 17 S Township 27 N Section 8
 NW $\frac{1}{4}$
 Elev. _____ T.D. 1010
 Date Drilled 5-16-29
 Correlation by _____
 Dry Prod-?

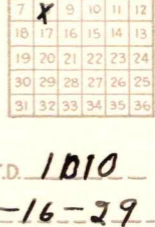

HF mud - 434' to 8' of top
 where 8" plug - was set.
 8" wood plug - 434'

HF M - 993' - 515'

$\frac{1}{4}$ " wood plug - 993'
 Hole filled with mud
 from 996' - 1010'

T. D. - 1010'