

GEOLOGICAL DEPARTMENT
SOUTHWESTERN GAS COMPANY
INDEPENDENCE, KANSAS

J. Templeton
PL

Company

9-27-16
S. T. R. Wilson
County Kansas
State Herrington #1
Lease and Well No.

Contractor

Drilling Commenced

Drilling Completed


Initial Production

Initial Rock Pressure

Location

$W\frac{1}{2}$ of $SW\frac{1}{4}$

Casing

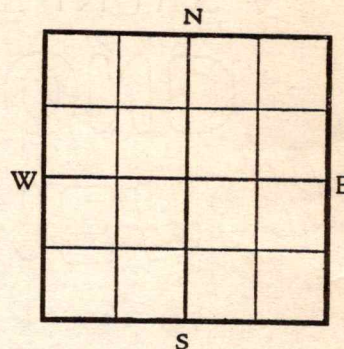

Driller's Record of Formations

2	soil	5	
5	shell rock	7	
30	lime	37	
108	shale	145	
15	lime	160	
20	shale	180	
55	lime	235	
50	shale	285	
20	lime	305	
5	shale black	310	
80	lime	390	
5	shale black	395	water
107	lime	502	
15	shale black	517	
98	shale W	615	
30	lime	635	
85	shale	710	
35	lime	745	
25	shale	770	little gas
18	lime	788	
5	shale black	793	
5	lime	798	
163	shale	961	
4	oil sand	965	
25	shale	990	
5	shale black	995	water
5	sand	1000	bottom of hole