

KANSAS


Sedg

Form 51-5M-2-29-34703

Map No. Sec. 13 Twp. 28 R. 1E

Well No. 1 - Parks Farm
Cameron-Cameron Company

NORTH

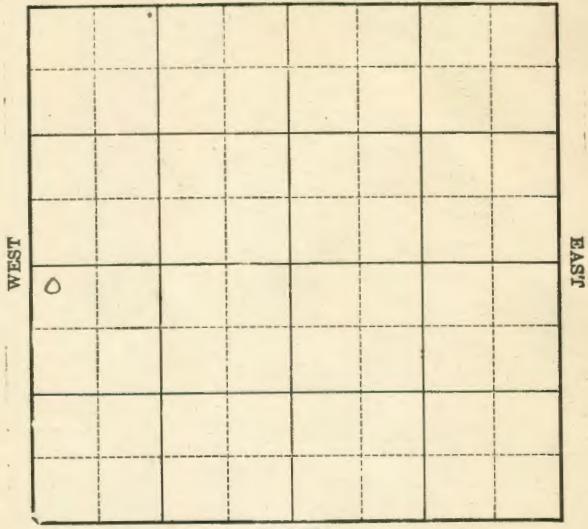

SOUTH

Location
Drilling Remarks

Rig Up
Drilling Remarks

RECORD

Cased in. ft.
 Sand
 Gas
 Oil
 Total Depth

PRODUCTION

1st 24 hrs. Nat.
 1st 24 hrs. after shot
 Gas cu. ft.
 Dry Hole
 Abandoned

Sedgwick
Form 252A-5M-11-29-38035

Map No. KANSAS Sec. 13 Twp. 28 R. 1E

Well No. 1 - Parks Farm
Cameron & Cameron Company

NORTH


330 Ft. from N. Line

_____ Ft. from S. Line

_____ Ft. from E. Line

330 Ft. from W. Line

1930

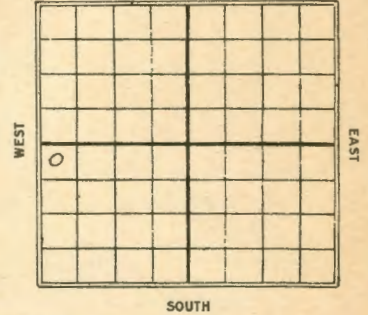

Date	REPORT
8/20	Rig up.
8/27	
9/3	Spud
9/10	Drly 620'
9/17	" 970'
9/24	Trg tools 1542'
10/1	10" - 1582'
	10 1/2" 2060'
10/8	Run 8" - 2600'
10/15	VIR 8" - 2742'
10/22	Drly 3032'
10/29	SD 3032'
11/5	
11/12	Sand 3020' HFW
	3081-90- Drly.
11/19	Top Chat 3052'
	Drly 3239'
11/25	5" - 3353'
12/2	Top Nucleox 3415'
	Drly line 3470' HFW
	TD 3475'
	Dry & abandon

Map No. **KANSAS** Sec. 13 Twp. 28 R. 1E

Well No. 1 Parks

Cameron & Cameron Company

Contractor

SECTION PLAT

330 Ft. from N. Line

_____ Ft. from S. Line

_____ Ft. from E. Line

330 Ft. from W. Line

ABANDONED

Location _____

Rig up _____

Drilling and Remarks:

Wilson 3415
Sil line 3470
XPW

RECORD

Cased _____ in., _____ ft.

Sand _____

Gas _____

Oil _____

Total Depth 3475

PRODUCTION

1st 24 hrs. Nat. _____

1st 24 hrs. after shot _____

Gas _____ Cu. Ft.

Dry Hole _____

Abandoned _____

Date

DEC 3 1930 S. J. LEWIS Scout

Map No. **KANSAS** Sec. 13 Twp. 28 R. 1E

Well No. 1 Parks

Cameron & Cameron Company

Contractor

FIRST REPORTS

SECTION PLAT

330 Ft. from N. Line

_____ Ft. from S. Line

_____ Ft. from E. Line

330 Ft. from W. Line

Location _____

Rig up

Drilling and Remarks:

RECORD

Cased _____ in., _____ ft.

Sand _____

Gas _____

Oil _____

Total Depth _____

PRODUCTION

1st 24 hrs. Nat. _____

1st 24 hrs. after shot _____

Gas _____ Cu. Ft.

Dry Hole _____

Abandoned _____

Date

AUG 20 1930 CHAS. L. SHERWOOD Scout