

# KANSAS


Sedgwick

Section 16 Township 28 Range 1E

Well No. 3 Brookings "A"

Company E. B. Shawver

Robbins  
NORTH

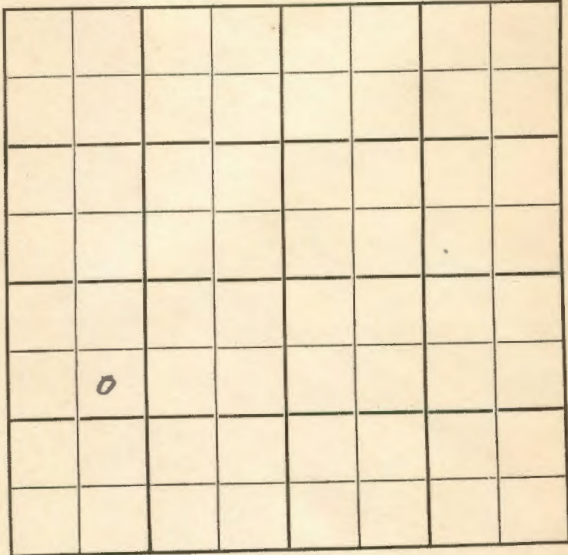

SOUTH

Sedgwick **KANSAS**

Sec. 16 Twp. 28 R. 1E ✓

Well No. #3 Brookings "A" Farm

E. B. Shawver Company

Robbins Pool


990' Ft. from N. Line

\_\_\_\_\_ Ft. from S. Line

\_\_\_\_\_ Ft. from E. Line

990' Ft. from W. Line

SE NW SW

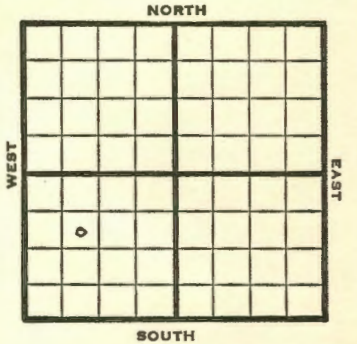

1949

**Elev 1272'**

REPORT

6/15

8" @ 86'  
Drlg. 810'

6/21

**KC 2590'**  
Drlg. 2720'

6/28

**Miss 3072'**  
5" @ 3072'  
TD 3097'

7/6

200' oil  
TD 3097'  
**Miss 3072'**  
5" @ 3072'  
4000 acid  
Pump 20 Oil Pot  
39° Gr.  
Comp

**COMPLETED**

Robbins Pool

Map No. K12 Sec. 16 Twp. 28 R. 1E

Well No. 3 Brookings "A"

E. B. Shawver Company

**COMPLETE** Contractor

SE NW SW

*E111272*  
SECTION PLAT

990 Ft. from N. Line

\_\_\_\_\_ Ft. from S. Line

\_\_\_\_\_ Ft. from E. Line

990 Ft. from W. Line

|  |  |  |  |
|--|--|--|--|
|  |  |  |  |
|  |  |  |  |
|  |  |  |  |
|  |  |  |  |

Sedgwick County

Location \_\_\_\_\_

Rig up \_\_\_\_\_

Drilling and Remarks:

*Max 3072*  
*8" @ 3072*  
*4000 rods*  
*Prog 30 oil Pt*

*3998*

RECORD

Cased \_\_\_\_\_ in., \_\_\_\_\_ ft.

Sand \_\_\_\_\_

Gas \_\_\_\_\_

Oil \_\_\_\_\_

Total Depth 3072

PRODUCTION

1st 24 hrs. Nat. \_\_\_\_\_

1st 24 hrs. after shot \_\_\_\_\_

Gas \_\_\_\_\_ Cu. Ft.

Dry Hole \_\_\_\_\_

Abandoned \_\_\_\_\_

Date \_\_\_\_\_

JUL 6 1949 19

S. J. LEWIS Scout

Sedgwick County Kansas State

Map No. \_\_\_\_\_ Sec. 16 Twp. 28 R. 1E

Well No. 3 Brookings "A"

E. B. Shawver Company

Contractor

SE NW SW.

FIRST REPORT  
SECTION PLAT

990 Ft. from N. Line

\_\_\_\_\_ Ft. from S. Line

\_\_\_\_\_ Ft. from E. Line

990 Ft. from W. Line

|  |  |  |  |  |  |
|--|--|--|--|--|--|
|  |  |  |  |  |  |
|  |  |  |  |  |  |
|  |  |  |  |  |  |
|  |  |  |  |  |  |
|  |  |  |  |  |  |

Robbins Pool

Remarks:

8" @ 86 dr lg. 810

Date JUN 15 1949

Scout S. J. LEWIS