

Sedgwick

KANSAS

16

28

1E

Section _____ Township _____ Range _____

#1 Lee


Well No. _____

C. A. Black et al

Company _____

Miscellaneous

NORTH

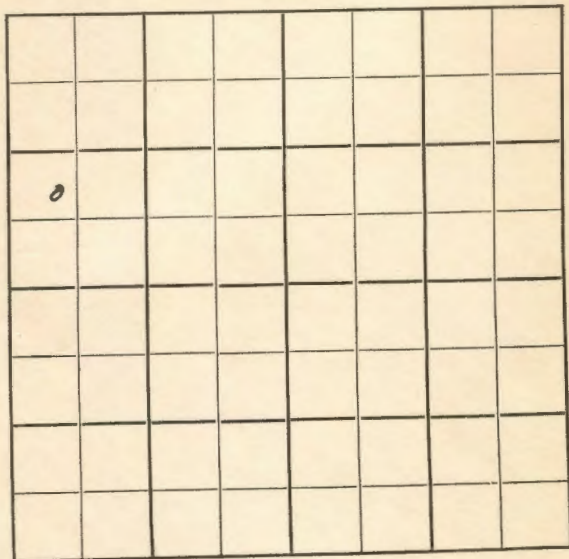

SOUTH

Sedgwick

KANSAS

16

28

1E

Sec. _____ Twp. _____ R. _____

Well No. #1 Lee Farm _____

C.A. Black et al

Company _____


Miscellaneous (Penguin Drlg., Contr.)

Ft. from N. Line

860' Ft. from S. Line

Ft. from E. Line

560' Ft. from W. Line

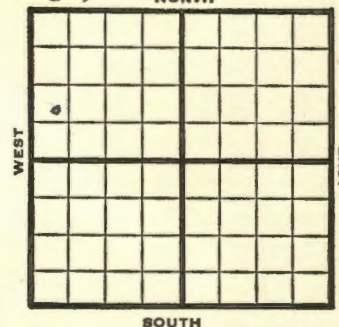

C N L SW NW

SOUTH

1949

Elev. 1273'

REPORT

12/7

8" @ 100'

12/14

2824' SD

12/21

Miss 3073-76'

TD 3076'

5" @ 3074

2000 acid

12/28

TD 3099'

1950

1/25

8" @ 100'

5" @ 3074'

Miss 3072'

KC 2595'

TD 3099'

D&A

ABANDONED

Map No. _____ Sec. 16 Twp. 28 R. 1E

Well No. 1 Lee

C. A. Black et al. Company

C N L SW NW Contractor

C N L SW NW

E. 1273
SECTION PLAT

ABANDONED			
0			

Ft. from N. Line

860 Ft. from S. Line

Ft. from E. Line

560 Ft. from W. Line

Sedgwick County

Location _____

Rig up _____

Drilling and Remarks:

8" @ 100

5" @ 3074

miss 3072

KC 2595

D + A.

RECORD

Cased in, _____ ft.

Sand _____

Gas _____

Oil _____

Total Depth 3099

PRODUCTION

1st 24 hrs. Nat. _____

1st 24 hrs. after shot _____

Gas _____ Cu. Ft.

Dry Hole _____

Abandoned _____

Date

JAN 25 1950

19

J. E. TYRA

Scout

Map No. _____ Sec. 16 Twp. 28 R. 1E

Well No. 1 Lee

C. A. Black et al. Company

Penguin Drlg. Contractor

C N L SW NW

FIRST REPORT
SECTION PLAT

0			

Ft. from N. Line

860 Ft. from S. Line

Ft. from E. Line

560 Ft. from W. Line

Sedgwick County

Location _____

Rig up _____

Drilling and Remarks:

8" @ 100

RECORD

Cased in, _____ ft.

Sand _____

Gas _____

Oil _____

Total Depth _____

PRODUCTION

1st 24 hrs. Nat. _____

1st 24 hrs. after shot _____

Gas _____ Cu. Ft.

Dry Hole _____

Abandoned _____

Date

DEC 7 1949

19

S. J. LEWIS

Scout