

Section 16 Township 28 Range 1E  
Well No. #1 Lockamp **Albert Lohkamp**  
Company E. V. Shawver

Sec. 16 Twp. 28 R. 1E  
Well No. #1 Lockamp Farm  
E. V. Shawver Company

Wildcat



Ft. from N. Line

330 Ft. from S. Line

330 Ft. from E. Line

Ft. from W. Line

SE NW

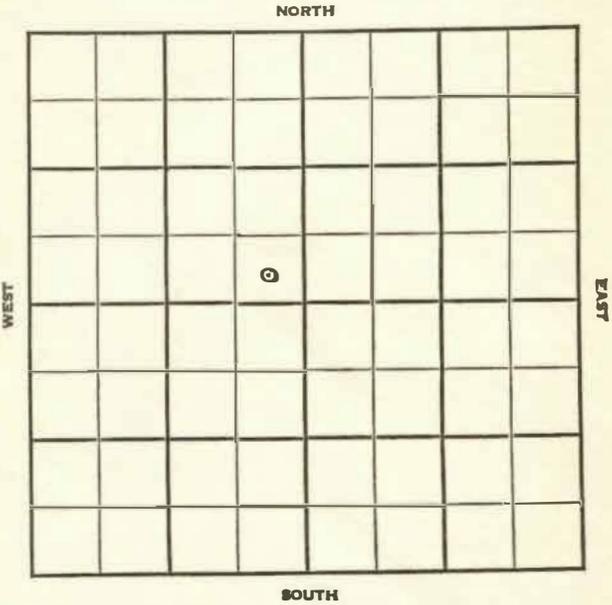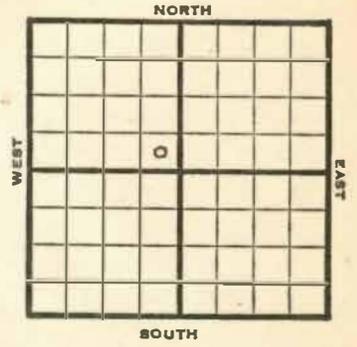

1948 **Elev. 1271'** REPORT

1/28 RUR  
2/4 8" @ 86'  
Drlg. 1906'  
2/11 Drlg. 3076'  
2/18 **Mississippi 3071'**  
5" @ 3071'  
TD 3094'  
2/25 **Miss. 3091'**  
5" @ 3071'  
Pump 100 Pot  
38.0 Gr.  
TD 3094'  
Comp.

**COMPLETED**

Map No. 12 Sec. 16 Twp. 28 R. 1E

Well No. 1 Lockamp

E. V. Shawver Company

**COMPLETE** Contractor

SE NW

*E 1/2 1/4*  
SECTION PLAT

Ft. from N. Line  
330 Ft. from S. Line  
330 Ft. from E. Line  
Ft. from W. Line


Sedgwick County

Location \_\_\_\_\_

RECORD

Cased \_\_\_\_\_ in., \_\_\_\_\_ ft.  
Sand \_\_\_\_\_  
Gas \_\_\_\_\_  
Oil   
Total Depth 3094

Rig up \_\_\_\_\_

Drilling and Remarks:

*Miss 3091*  
*5" @ 3071*  
*Produced by*

PRODUCTION

1st 24 hrs. Nat. \_\_\_\_\_  
1st 24 hrs. after shot \_\_\_\_\_  
Gas \_\_\_\_\_ Cu. Ft.  
Dry Hole \_\_\_\_\_  
Abandoned \_\_\_\_\_

Date

FEB 25 1948 19 S. J. LEWIS Scout

Map No. \_\_\_\_\_ Sec. 16 Twp. 28 R. 1E

Well No. 1 Lockamp

E. V. Shawver Company

**FIRST REPORT** Contractor

SE NW

SECTION PLAT

Ft. from N. Line  
330 Ft. from S. Line  
300 Ft. from E. Line  
Ft. from W. Line


Sedgwick County

Location \_\_\_\_\_

RECORD

Cased \_\_\_\_\_ in., \_\_\_\_\_ ft.  
Sand \_\_\_\_\_  
Gas \_\_\_\_\_  
Oil \_\_\_\_\_  
Total Depth \_\_\_\_\_

Rig up \_\_\_\_\_

Drilling and Remarks:

R U R

PRODUCTION

1st 24 hrs. Nat. \_\_\_\_\_  
1st 24 hrs. after shot \_\_\_\_\_  
Gas \_\_\_\_\_ Cu. Ft.  
Dry Hole \_\_\_\_\_  
Abandoned \_\_\_\_\_

Date

JAN 28 1948 19 S. J. LEWIS Scout