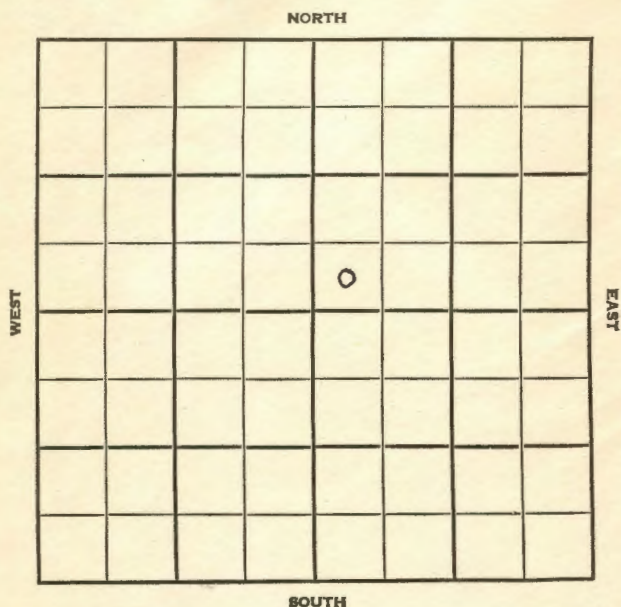


Sedgwick

KANSAS

Section 18 Township 28 Range 1 EWell No. #1 DavisCompany H & M Drlg.

Sedgwick

KANSAS

SEC. 18 TWP. 28 R. 1E

WELL NO.

#1 Davis

FARM

COMPANY

H & M Drlg.

CONTRACTOR

Co. Tools

Robbins


_____ Ft. from N. Line

_____ Ft. from S. Line

_____ Ft. from E. Line

_____ Ft. from W. Line

SW SW NE

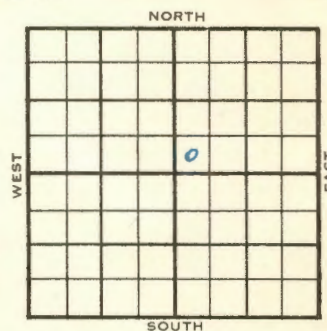

1955

ELEVATION

REPORT

10/5

Comm 10-1-55

8" @ 150

Drlg 1100

10/19

Comm 10-1-55

KC 2714

M Lm 3154

S 3488

TD 3508

8" @ 150 DST 3498-3508 open 1 hr

Rec 60' mud 340#

D & A

ABANDONED

County Sedgwick Elev. _____
 Sec. 18 Twp. 28 Rge. 1E
 Company H & M Drilling
 Farm Name Davis No. 1

TOPS	DEPTH	LOG	DATUM	Loc. in Sec.
Anh.				SW SW NE
Tr.				
H.				
Tr.				
Dg.				
Bl.				
L.				Geol.
K.C.	<u>2714</u>			Contr.
B.K.C.				Co. tools
Ce.				Pool
C.				Robbins
M.	<u>3154</u>			
M.				
K.				
Mz.				
Mo.				
V.				
S.	<u>3488</u>			
S.				
A.				
R.				
Pe.				
G.				
T.D.	<u>3508</u>			

Date Comm. 10-1-55 OCT 1 9 1955

8" @ 150 DST 3498-3508 open 1 hr.

Rec. 60' mud 340#

D & A

County Sedgwick Elev. _____
 Sec. 18 Twp. 28 Rge. 1E
 Company H & M Drilling
 Farm Name Davis No. 1

TOPS	DEPTH	LOG	DATUM	Loc. in Sec.
Anh.				SW SW NE
Tr.				
H.				
Tr.				
Dg.				
Bl.				
L.				Geol.
K.C.				Contr.
B.K.C.				Co. tools
Ce.				Pool
C.				Robbins
M.				
M.				
K.				
Mz.				
Mo.				
V.				
S.				
S.				
A.				
R.				
Pe.				
G.				
T.D.				

Date Comm. 10-1-55

8" @ 150 drlg. 1100

FIRST REPORT