



Section 18 Township 28 Range 1-E
Well No. 1 - Martin
Company Muffin et al

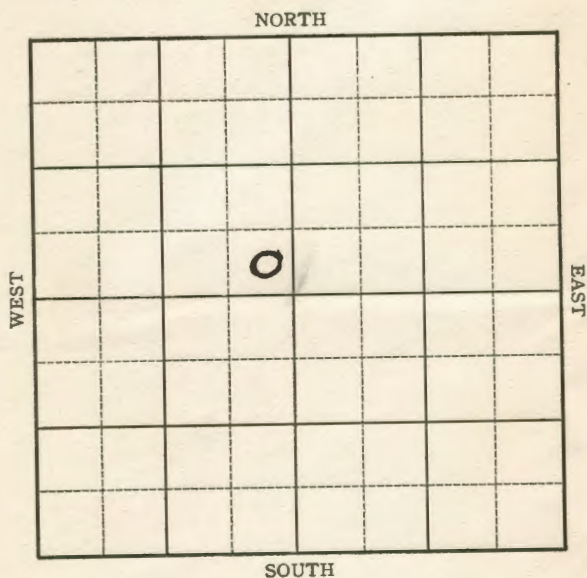

Sec. 18 Twp. 28 R. 1-E
Well No. #1 Martin Farm
Murfin et al Company

_____ Ft. from N. Line
330 Ft. from S. Line
330 Ft. from E. Line
_____ Ft. from W. Line

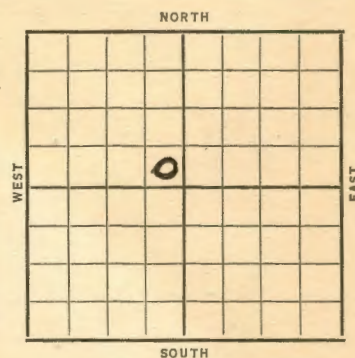

Elev. 1275

[illegible]

534114

1937

10/26--Base Miss. 3420 ³⁴⁹¹
 Top Wilcox ~~3421~~ T.D. ~~3492~~
 Filled up 1000 feet oil last foot
 Hole bridged 800 feet off bottom (Tel)

10/29 Base Miss. 3415'.
 Top Wilcox 3489'. T.D. 3491'.
 800' oil 10 min. 6" @ 3489'.
 C.O.

11/5 3000' oil. Pumped 475 bbls. oil
 24 hrs. (Down 8 hrs)
 No water. Grav. 46.9
 Cementing 6" @ 3489'.

11/12 3000' oil. Pump 110 bbls. 10
 hrs. 1000 acid.

11/19 " " " "

11/26 " " " "

12/3 Installing pumping unit.

12/10 " " " "

12/17 " " " "

12/24 " " " "

12/31 " " " "

1938

1/7 " " " "

1/14 " " " "

1/20 " " " "

1/28 " " " "

2/4 " " " "

2/9 6" @ 3489'.

Wilcox 3489'.

T.D. 3491'.

15 bbls.

Minimum well.

COMPLETED

Form 26-1M Bks.-2-29 **KANSAS** *Sedgwick*
Map No. *12* Sec. *18* Twp. *28* R. *1E*
Well No. *1-Martin*
Murfin etal Company
Contractor

FIRST REPORT

SECTION PLAT

		0	

_____ Ft. from N. Line
330 Ft. from S. Line
330 Ft. from E. Line
_____ Ft. from W. Line

Location ☒

RECORD

Cased _____ in., _____ ft.
Sand _____
Gas _____
Oil _____
Total Depth _____

PRODUCTION

1st 24 hrs. Nat. _____
1st 24 hrs. after shot _____
Gas _____ Cu. Ft.
Dry Hole _____
Abandoned _____

Date

AUG 4 1937

H. D. Hatfield Scout

Form 26-1M Bks.-2-29 *Sedgwick* **KANSAS**
Map No. *12* Sec. *18* Twp. *28* R. *1E*
Well No. *1 Martin*
Murfin etal Company
Contractor

COMPLETED

SE NW

SECTION PLAT

		0	

_____ Ft. from N. Line
330 Ft. from S. Line
330 Ft. from E. Line
_____ Ft. from W. Line

Location _____

RECORD

Rig up _____
Drilling and Remarks:

Cased *6* in., *3489* ft.
Sand *Wilcox* *3489*
Gas _____
Oil _____
Total Depth *3491*

PRODUCTION

1st 24 hrs. Nat. _____
1st 24 hrs. after shot _____
Gas _____ Cu. Ft.
Dry Hole _____
Abandoned _____

Date

FEB 9 1938

H. D. Hatfield Scout

15 bbl
Min well