


Sedgwick KANSAS


Section 16 Township 28 Range 1E
 Well No. 4 Brookings "A"
 Company Stelbar Oil

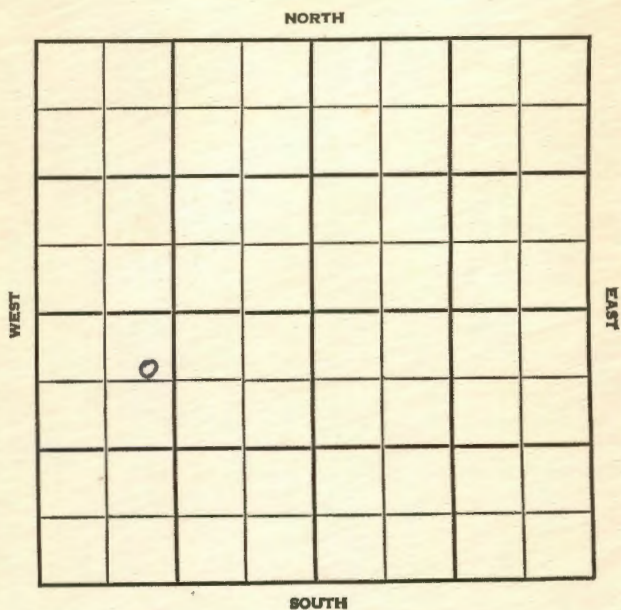

Sedgwick KANSAS

SEC. 16 TWP. 28 R. 1 E
 WELL NO. # 4 Brookings "A" FARM
 COMPANY Stelbar Oil
 CONTRACTOR Stelbar Oil

Co. tools
Robbins Pool
500 Ft. from N. Line
 _____ Ft. from S. Line
 _____ Ft. from E. Line
1150 Ft. from W. Line

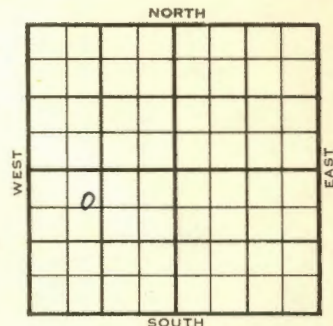

NE NW SW

1954 ELEVATION 1272' REPORT

12/22 Spud 12-18-54
 8" @ 88
 Drlg. 365'

1955
 1/26 Spud 12-18-54
 D & A TD 3132' 8" @ 88 KC 2585
 Cong. 3079 TD 3082 5" @ 3081
 DD 3085 DD 3132 Miss. dolo 3082
 Miss sh. 3088'
 D & A

ABANDONED

County **Sedgwick** State **Kansas**

County **Sedgwick** State **Kansas**

Sec. **16** (Blk. Twp.) **28** (Sur. Rge.) **1E** Map No.

Sec. **16** (Blk. Twp.) **28** (Sur. Rge.) **1E** Map No.

Operator **Stelbar Oil**

Operator **Stelbar Oil**

Well No. **4** Farm **Brookings "A"**

Well No. **4** Farm **Brookings "A"**

Elev. **1272** Location **NE NW SW**

Elev. Location **NE NW SW**

500 Ft. From **N** Line **SW**

500 Ft. From **N** Line **SW**

1150 Ft. From **W** Line **Quarter**

1150 Ft. From **W** Line **Quarter**

1st. Report

1st. Report **DEC 22 1954**

Completion **JAN 26 1955**

Completion

Remarks **Robbins Pool**

Remarks

Co. tools

Co. tools

Spudding Date **12-18-54**

Spudding Date **12-18-54**

Drig. Data **D & A TD 3132**

Drig. Data **Robbins Pool**

8" @ 88 KC 2585 Cong. 3079

8" @ 88 Drig. 365

TD 3082 5" @ 3081 DD 3085

DD 3132 Miss. dolo 3082 Miss. sh. 3088

D & A

FABEN GILSTRAP

FABEN GILSTRAP