

Section 16 Township 28 Range 1E

Well No. #3 Lopkamp Lohkamp

Company E. B. Shawver

Miscellaneous

NORTH

WEST

EAST

SOUTH

Sec. 16 Twp. 28 R. 1E

Well No. #3 Lopkamp Lohkamp Farm
E. B. Shawver Company


Miscellaneous (Shawver, Contr.) NORTH

1175' Ft. from N. Line

_____ Ft. from S. Line

_____ Ft. from E. Line

1322' Ft. from W. Line

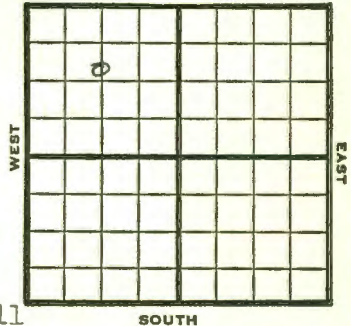

SE NW NW Twin Well

1949

REPORT

2/7 10" @85'
Drlg. 200'

2/14 Drlg. 2588'

1950
1/4 TD 3080'
10" @ 85'
Miss 3065'
5" @ 3065'
Pump 80 Oil
No wtr.
Comp

COMPLETED

Kansas

Map No. _____ Sec. 16 Twp. 28 R. 1E

Well No. 3 Lopkamp

E. B. Shawver Company

Shawver Contractor

SE NW NW

FIRST REPORT
SECTION PLAT

1175 Ft. from N. Line

_____ Ft. from S. Line

_____ Ft. from E. Line

1322 Ft. from W. Line

Sedgwick County

o			

Location _____

Rig up _____

Drilling and Remarks:

twin well

10" @ 85

drlg. 200

RECORD

Cased _____ in., _____ ft.

Sand _____

Gas _____

Oil _____

Total Depth _____

PRODUCTION

1st 24 hrs. Nat. _____

1st 24 hrs. after shot _____

Gas _____ Cu. Ft.

Dry Hole _____

Abandoned _____

Date

DEC 7 1949 19

S. J. LEWIS Scout

Map No. _____ Sec. 16 Twp. 28 R. 1E

Well No. 3 Lohkamp

E. B. Shawver Company

Contractor

SE NW NW


SECTION PLAT

1175 Ft. from N. Line

Ft. from S. Line

Ft. from E. Line

1322 Ft. from W. Line

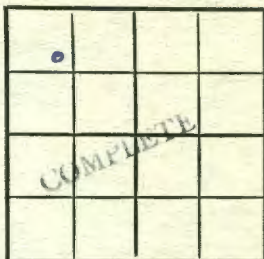

Sedgwick County

RECORD

Location _____

Cased _____ in., _____ ft.

Rig up _____

Sand _____

Drilling and Remarks:

Gas _____

10" @ 85

Oil _____

Miss 3065

Total Depth 3080

5" @ 3065

Pump 80 oil
no water

PRODUCTION

1st 24 hrs. Nat. _____

1st 24 hrs. after shot _____

Gas _____ Cu. Ft.

Dry Hole _____

Abandoned _____

Date

JAN 4 1950 19

J. E. Lynn Scout