

Section 16 Township 28S Range 1E

Sec. 16 Twp. 28 R. 1E


Well No. #1 Weiss Unit

Well No. #1 Weiss Unit Farm

Company E. B. Sawyer

E. B. Sawyer Company

Miscellaneous (Shawver, Cont.)

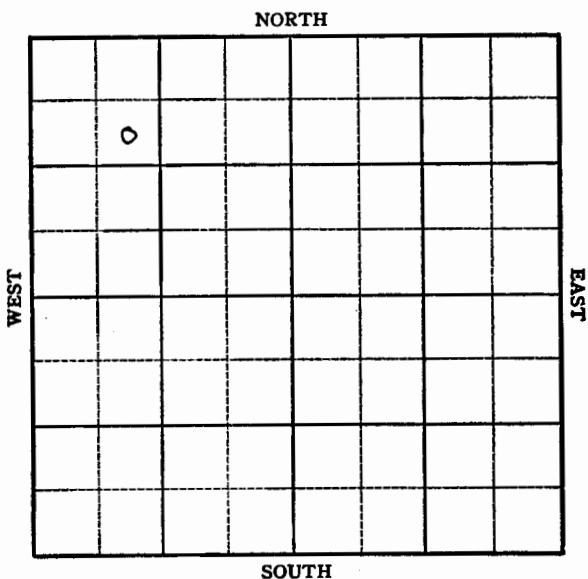


990' Ft. from N. Line

_____ Ft. from S. Line

_____ Ft. from E. Line

990' Ft. from W. Line

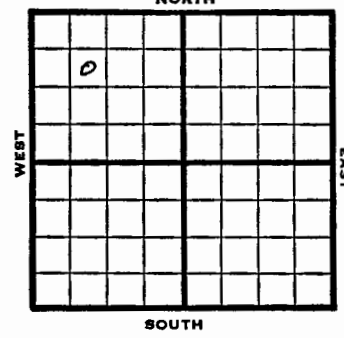

SE NW NW

1949		REPORT
		Elev 1274'
9/14	8" @ 82'	
	Drlg. 135'	
9/21	Drlg. 2375'	
9/28	Miss 3082'-37'	
	TD 3087'	
	5" @ 3082'	
10/5	TD 3087'	
10/12	"	
10/19	TD 3090'	
10/26	"	
11/1	TD 3094'	
11/9	TD 3094'	
	Miss 3082'	
	5 @ 3082'	
	5000 acid	
	Pump 20 Oil Pot	
	39° Gr.	
	Comp	
		COMPLETED

Map No. _____ Sec. 16 Twp. 28 R. 1E

Well No. 1 Weiss Unit

E. B. Shawver Company

COMPLETE Contractor

SE NW NW

E41274
SECTION PLAT

990 Ft. from N. Line

_____ Ft. from S. Line

_____ Ft. from E. Line

990 Ft. from W. Line

0			

Sedgwick County

Location _____

Rig up _____

Drilling and Remarks:

Misc 3082
5" @ 3082
5" @ 3082
Prop 201010
892

RECORD

Cased _____ in., _____ ft.

Sand _____

Gas _____

Oil _____

Total Depth 3082

PRODUCTION

1st 24 hrs. Nat. _____

1st 24 hrs. after shot _____

Gas _____ Cu. Ft.

Dry Hole _____

Abandoned _____

Date

NOV 9 1949 19 _____ S. J. LEWIS Scout

Map No. _____ Sec. 16 Twp. 28 R. 1E

Well No. 1 Weiss Unit

E. B. Shawver Company

Shawver Contractor

SE NW NW

SECTION PLAT

990 Ft. from N. Line

_____ Ft. from S. Line

_____ Ft. from E. Line

990 Ft. from W. Line

0			

Sedgwick County

Location _____

Rig up _____

Drilling and Remarks:

8" @ 82
drlg. 135

RECORD

Cased _____ in., _____ ft.

Sand _____

Gas _____

Oil _____

Total Depth _____

PRODUCTION

1st 24 hrs. Nat. _____

1st 24 hrs. after shot _____

Gas _____ Cu. Ft.

Dry Hole _____

Abandoned _____

Date

SEP 14 1949 19 _____ S. J. LEWIS Scout