


KANSAS

Form 51-5M-7-40-Palace

Sedgwick

Section 18 Township 28 Range 1-E  
Well No. #1 Vilm  
Company Max Steinbuchel

NORTH Wildcat

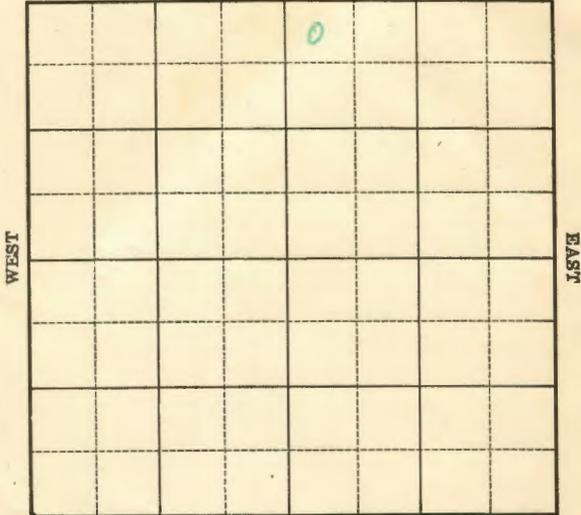

SOUTH

FORM 252-A 5M 7-40 PETROL


KANSAS

Sedgwick

Sec. 18 Twp. 28 R. 1-E  
Well No. #1 Vilm Farm  
Max Steinbuchel Company

(Wildcat)

330 Ft. from N. Line  
Ft. from S. Line  
Ft. from E. Line  
330 Ft. from W. Line

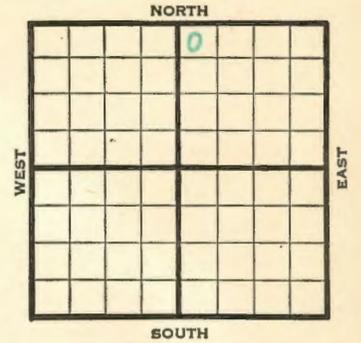

Elev. 1281

1940	REPORT
9/4	Cable.
9/5	"
9/12	Spud & SD.
9/19	15" - 61' Drlg. 755'
9/26	12" - 1230' Drlg. 1540'
10/3	10" - 1593' Drlg. 2055'
10/10	K.C. 2608' 8" - 27 15'
	Drlg. 2795'
10/17	3031' U.R. 8".
10/24	8" - 3105' SD.
10/30	Miss. 3083'
	B. Miss. 3412'
	5" - 3475'
	T.D. 3526'
	H.F.W.
	ABANDONED

Map No. 12 Sec. 18 Twp. 28 R. 1E

Well No. 1 Vilm

Max Steinbuchel Company

Contractor

ABANDONED

NW NE

SECTION PLAT


330 Ft. from N. Line

Ft. from S. Line

Ft. from E. Line

330 Ft. from W. Line

WILDGAT

Location \_\_\_\_\_

RECORD

Cased \_\_\_\_\_ in., \_\_\_\_\_ ft.

Sand \_\_\_\_\_

Gas \_\_\_\_\_

Oil \_\_\_\_\_

Total Depth 3526

PRODUCTION

1st 24 hrs. Nat. \_\_\_\_\_

1st 24 hrs. after shot \_\_\_\_\_

Gas \_\_\_\_\_ Cu. Ft.

Dry Hole \_\_\_\_\_

Abandoned \_\_\_\_\_

Rig up \_\_\_\_\_

Drilling and Remarks:

*Miss 3083  
B. Miss 3412  
5" @ 3475  
AFW*

Date

OCT 30 1940

S. J. LEWIS Scout

Map No. 12 Sec. 18 Twp. 28 R. 1E

Well No. 1 Vilm

Max Steinbuchel Company

Contractor

FIRST REPORT

NW NE

330 Ft. from N. Line

Ft. from S. Line

Ft. from E. Line

330 Ft. from W. Line

WILDGAT

SECTION PLAT


Location \_\_\_\_\_

RECORD

Cased \_\_\_\_\_ in., \_\_\_\_\_ ft.

Sand \_\_\_\_\_

Gas \_\_\_\_\_

Oil \_\_\_\_\_

Total Depth \_\_\_\_\_

PRODUCTION

1st 24 hrs. Nat. \_\_\_\_\_

1st 24 hrs. after shot \_\_\_\_\_

Gas \_\_\_\_\_ Cu. Ft.

Dry Hole \_\_\_\_\_

Abandoned \_\_\_\_\_

Rig up \_\_\_\_\_

Drilling and Remarks:

Cable

Date

SEP 4 1940

S. J. LEWIS Scout