


KANSAS

Section 19 Township 28 Range 1 E

Well No. #2 Howard

Company Shawver-Armour

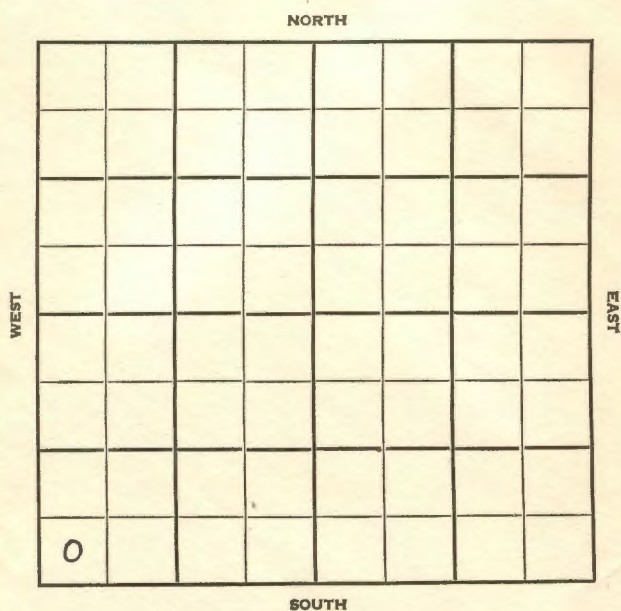

SEC.		TWP.		R.	
19		28		1E	

WELL NO. #2 Howard

COMPANY FARM

Shawver-Armour

CONTRACTOR

Co. Tools

~~Gladys~~


Ft. from N. Line

Ft. from S. Line

Ft. from E. Line

Ft. from W. Line

SW SW SW

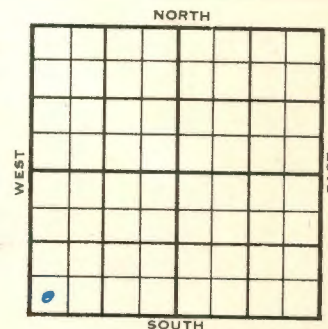

1955	ELEVATION 1276	REPORT
------	-------------------	--------

8/24	Comm 8-20-55 8 ⁿ @ 165/170 Drlg 2140
------	---

8/31 Comm 8-20-55

Anh Stal 2268

KC 2631

M Lm 3147

TD ~~3205~~ 3205

8ⁿ @ 165/170

DST 2742-66 open 1 hr

Rec 190' vsgcm 920#

D & A

ABANDONED

County Sedgwick Elev. 1276
Sec. 19 Twp. 28 Rge. 1E
Company Shawver-Armour
FarmName Howard No. 2

TOPS	DEPTH	LOG	DATUM	Loc. in Sec.
Anh.				SW SW SW
TP.				
H.				
Tr.				
Dg.				
Bl.				
L.				
K.C.				Geol.
B.K.C.				Contr.
Ce.				Co. tools
C.				
M.				Pool
M.				Gladys
K.				
Mz.				
Mq.				
V.				
S.				
S.				
A.				
R.				
Pe.				
G.				
TD.				

Loc. in Sec. SW SW SW
Geol.
Contr.
Co. tools
Pool
Gladys

8-20-55
8" @ 165/170 - d rlg. 2140

FIRST REPORT

County Sedgwick Elev. 1276
Sec. 19 Twp. 28 Rge. 1E
Company Shawver-Armour
FarmName Howard No. 2

TOPS	DEPTH	LOG	DATUM	Loc. in Sec.
Anh. <u>Star</u>	<u>2268</u>		<u>992</u>	SW SW SW
TP.				
H.				
Tr.				
Dg.				
Bl.				
L.				
K.C.	<u>2631</u>		<u>1355</u>	Geol.
B.K.C.				Contr.
Ce.				Co. tools
C.	<u>lm</u>	<u>3147</u>	<u>1871</u>	
M.				Pool
M.				Gladys
K.				
Mz.				
Mq.				
V.				
S.				
S.				
A.				
R.				
Pe.				
G.				
TD.	<u>3205</u>			

Loc. in Sec. SW SW SW
Geol.
Contr.
Co. tools
Pool
Gladys

8-20-55
8" @ 165/170 DST 2742-66 open 1 hr.
Rec. 190' vsgcm 920#
D & A

ABANDONED